4328 RV.2

EXHIBIT "B"

LEGEND

UNIT BOUNDARY

GENERAL COMMON ELEMENTS

LIMITED COMMON ELEMENTS

PATIO - DENOTES UNCOVERED AREA

CONC - DENOTES CONCRETE SLAB ON GRADE CONSTRUCTION

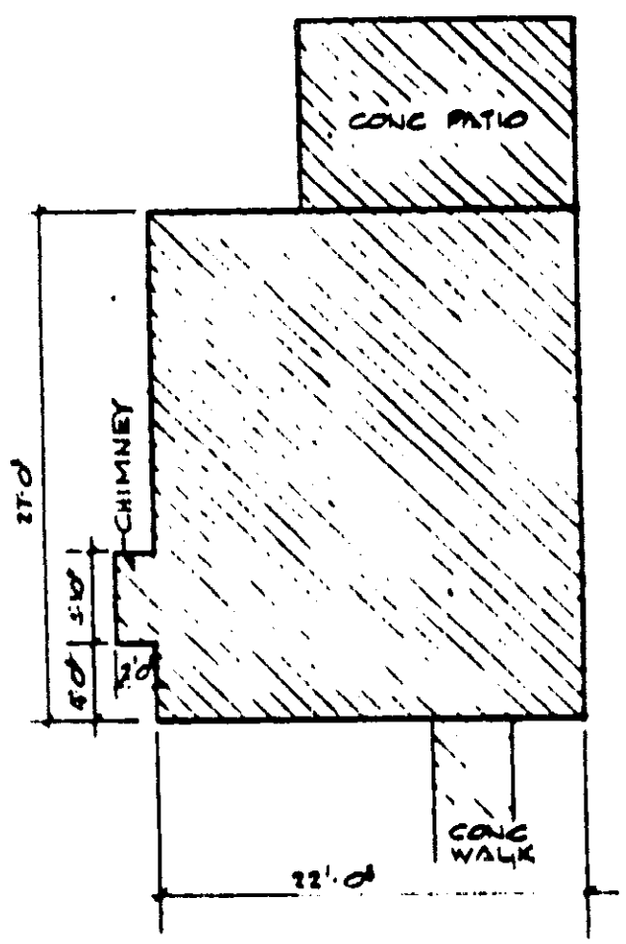

FOUNDATION PLAN

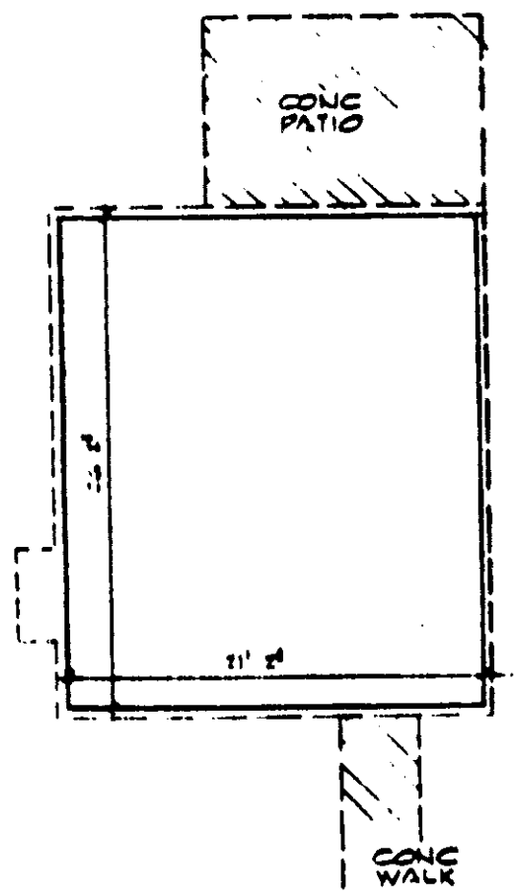

FIRST FLOOR PLAN

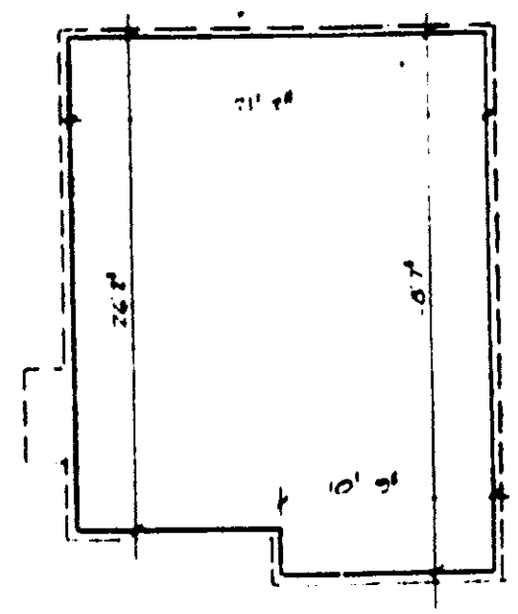

SECOND FLOOR PLAN

I, M. WILLIAM BASHOR JR., HEREBY CERTIFY THAT THE WITHIN FLOOR PLANS ARE TRUE AND CORRECT TO THE BEST OF MY KNOWLEDGE

M. WILLIAM BASHOR JR.
SC REGISTRATION # 10[illegible]

UNIT **406**

BASHOR-PALMER ASSOCIATES • ARCHITECTS ENGINEERS • GREENVILLE S.C.

SUMMER VILLAGE HORIZONTAL PROPERTY REGIME