



3  
8  
8  
0

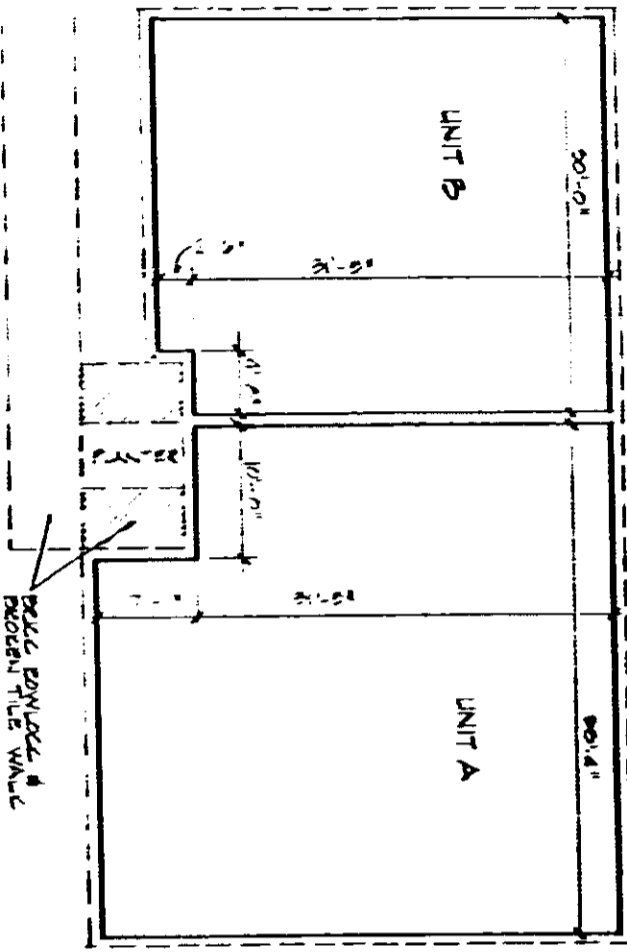

FLOOR PLAN

**LEGEND**

UNIT BOUNDARY  
 GENERAL COMMON AREA  
 UNITS LIMITED COMMON AREA  
 CONCRETE CONCRETE SUB ON GRADE CONSTRUCTION

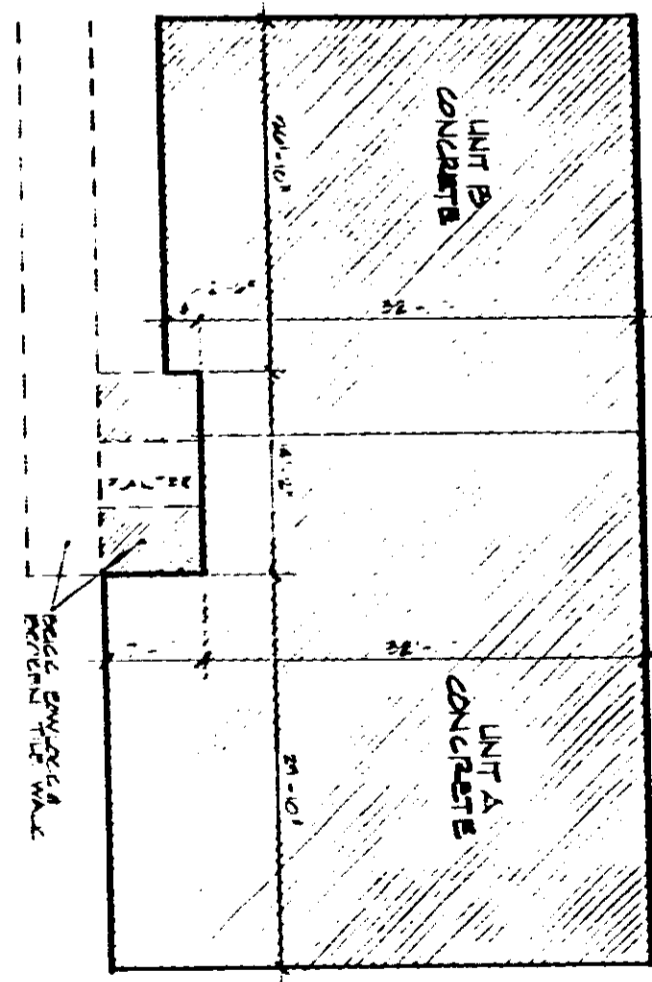

FOUNDATION PLAN

I, M. William Baber, Jr., hereby certify that the within floor plan are true and correct, and that Units A and B, referred to above, constructed on the subject property were constructed according to said plans.

*M. William Baber, Jr.*  
 M. William Baber, Jr.  
 S. C. Registration No. 1180

BASHOR-PALMER ASSOCIATES • ARCHITECTS ENGINEERS • GREENVILLE SC

GREENLAND DRIVE HORIZONTAL PROPERTY REG. VE  
EXHIBIT "C"

EXHIBIT "C"

LWB  
RBM  
DATE: 4-11-05

(CONTINUED ON NEXT PAGE)

3  
8  
8  
0