

Name and Post Office Address of Grantor: Dr. & Mrs. A. O. Simmons
24 Potomac Avenue
Greenville, South Carolina

Title No. _____

Toll Line or Exchange Line tributary to: Potomac Avenue SAC Interface
 (Name) _____


Greenville, South Carolina
 (Exchange) _____

The Property is bounded where the line enters and leaves this property by the property of:
Potomac Avenue on the South
Stanley J. & Susie Magusiak on the West

Authority: C-8155 Classification: R45C

Area: South Carolina

Approved: 29 Jyle
 Title: Segment Manager-Engineering/LAC

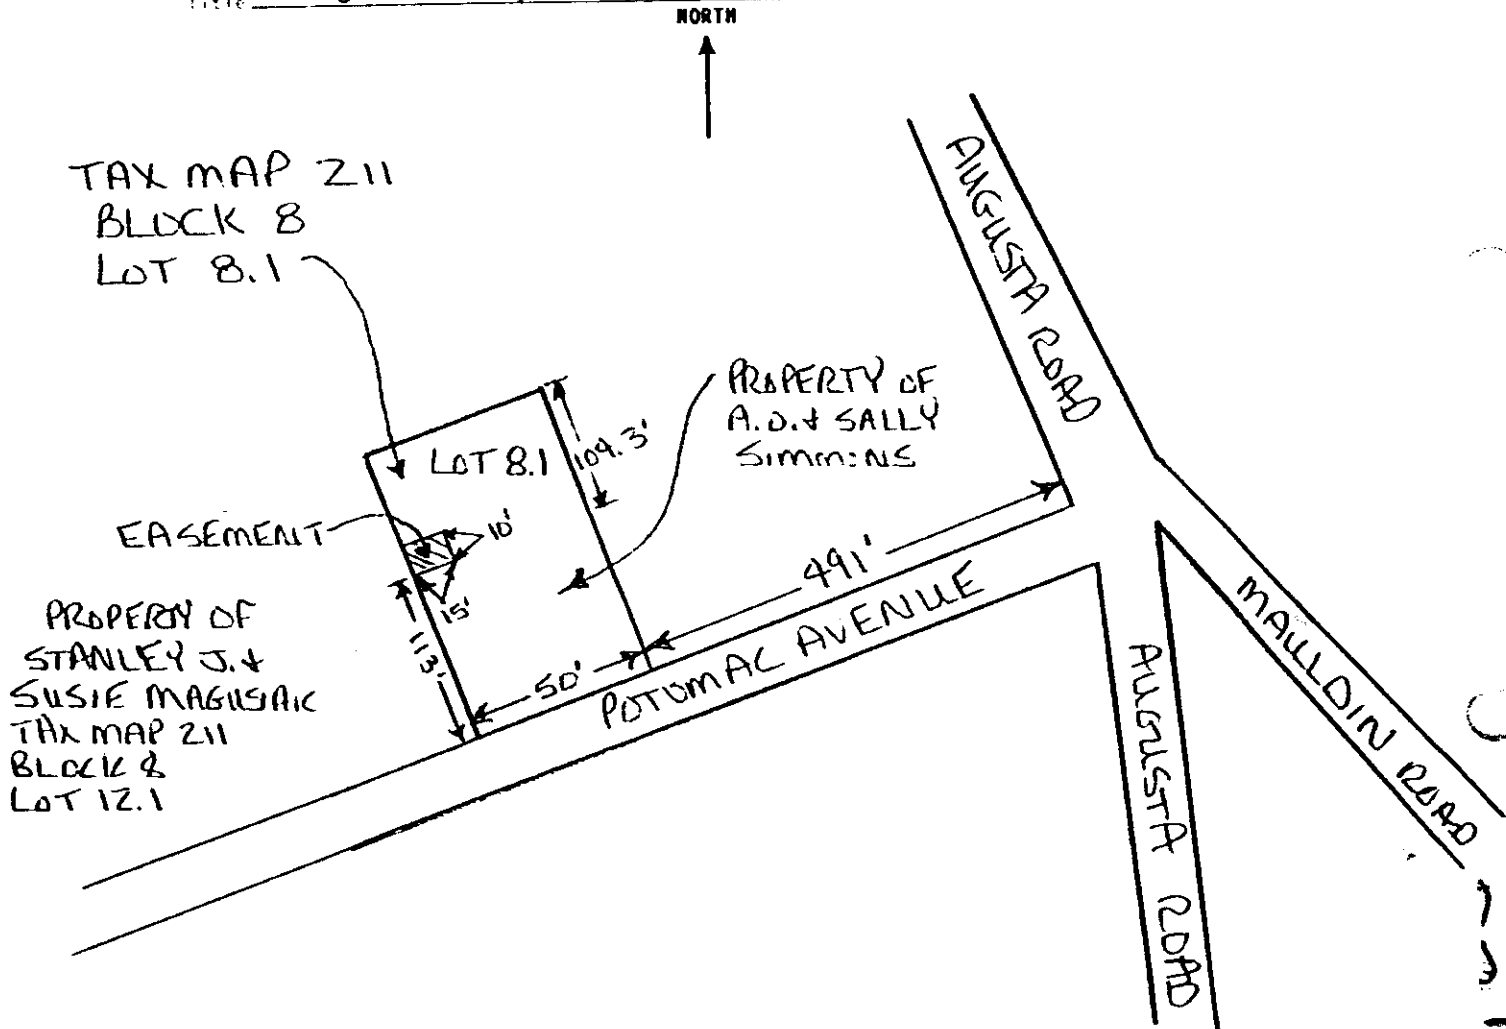

RECORDED FEB 10 1984 at 10:39 A/M

21668



Mail
 Boulevard Road
 P.O. B. 407
 Greenville, SC 29603
 ATT: Gene Anderson

FILED
 FEB 10 1984
 X227629X

Filed for record in the office of
 the R. M. C. for Greenville
 county, S. C. at 10:39 clock
 A/M Feb. 10, 1984
 and recorded in Deed Book
 1206 at page 97
 R. M. C. for G. Co. S. C.

21668