


11
E
E
E
E
E

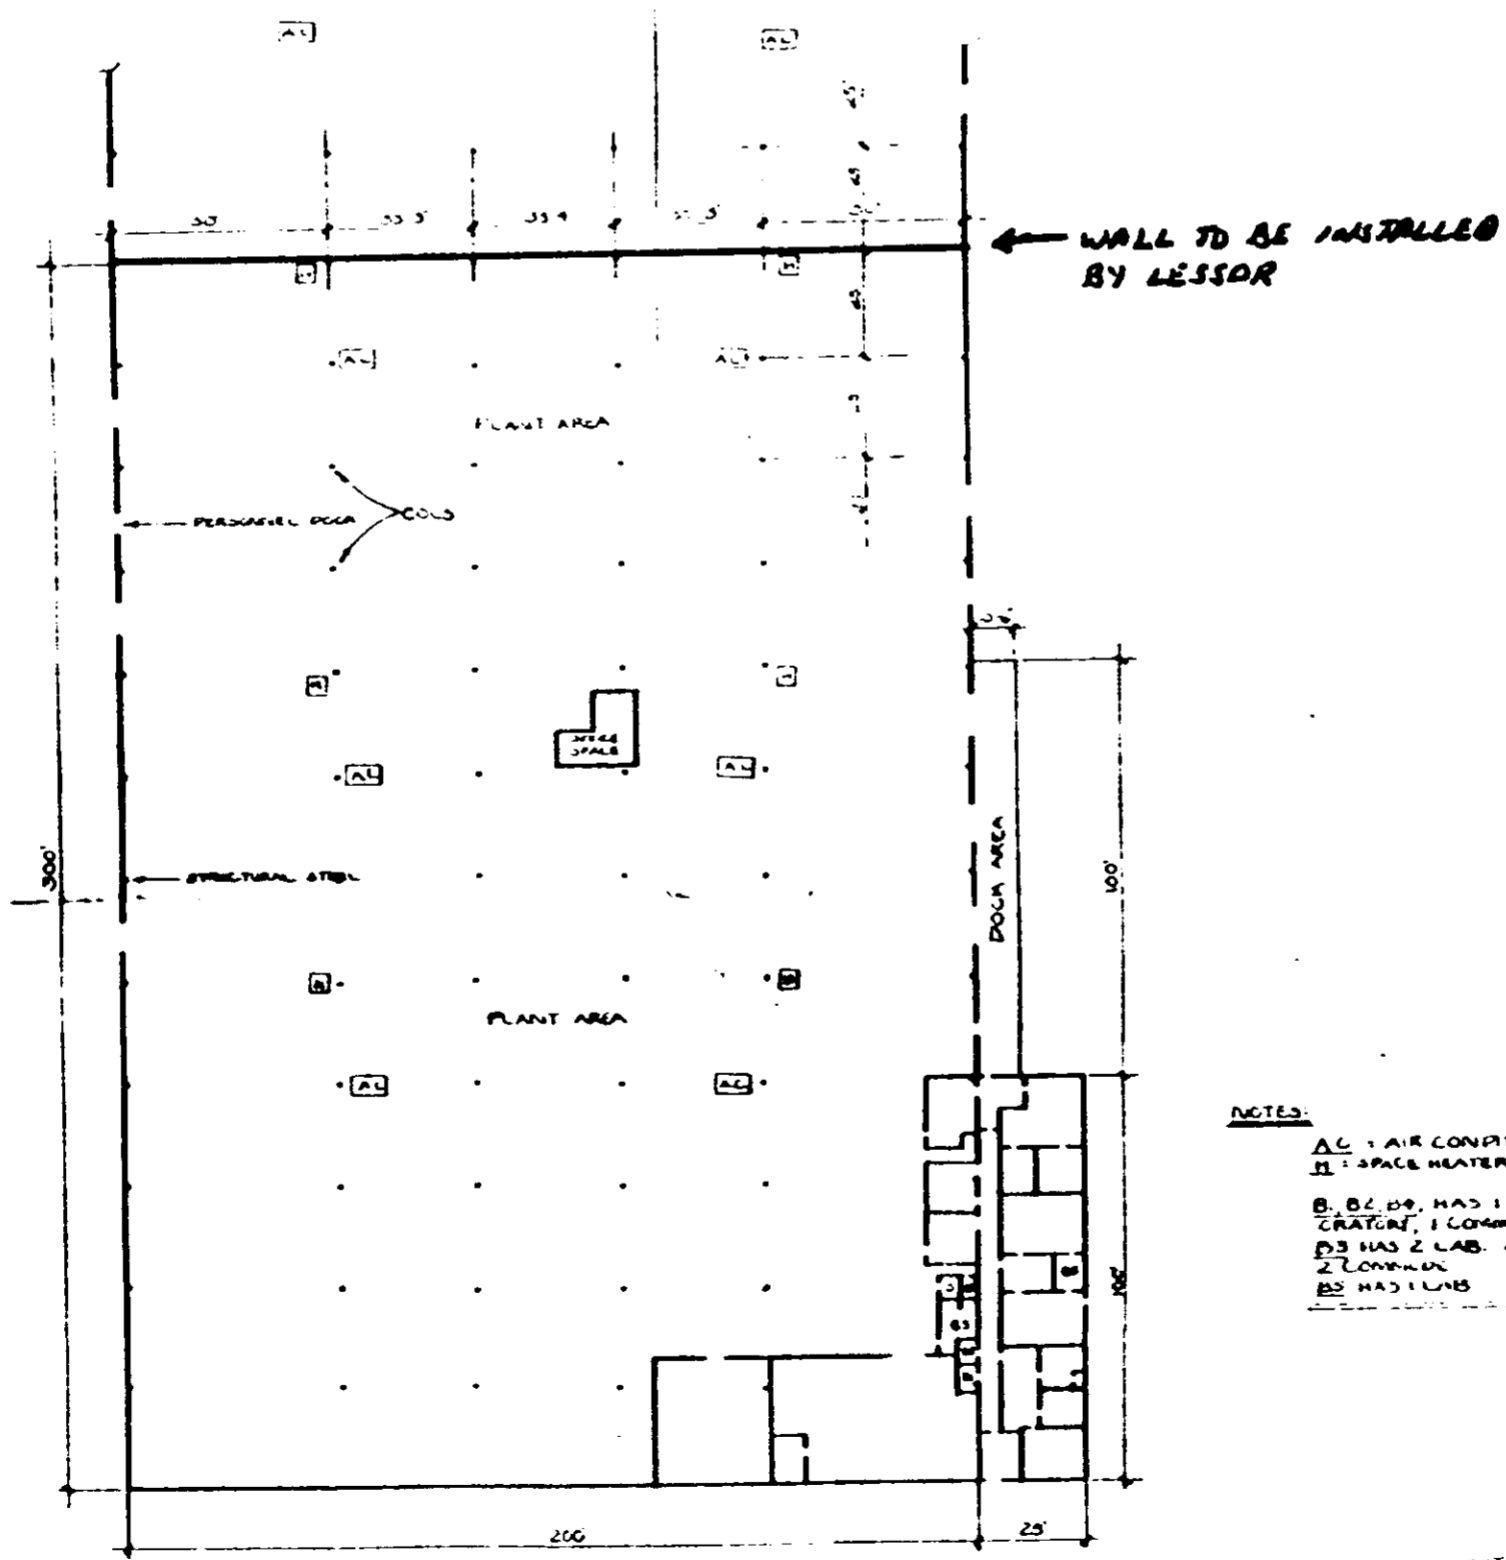

NOTES:
 AC - AIR CONDITION
 H - SPACE HEATER
 B, B2, B3, HAS 1 LAB
 CRATOR, 1 COMMODE
 B3 HAS 2 LAB. AND
 2 COMMODE
 B5 HAS 1 LAB

FLOOR PLAN

(CONTINUED ON NEXT PAGE)



EXHIBIT B

JET REST FURNITURE
EQUIPMENT

4328 RV 2