Plat Book 4A, Page 43

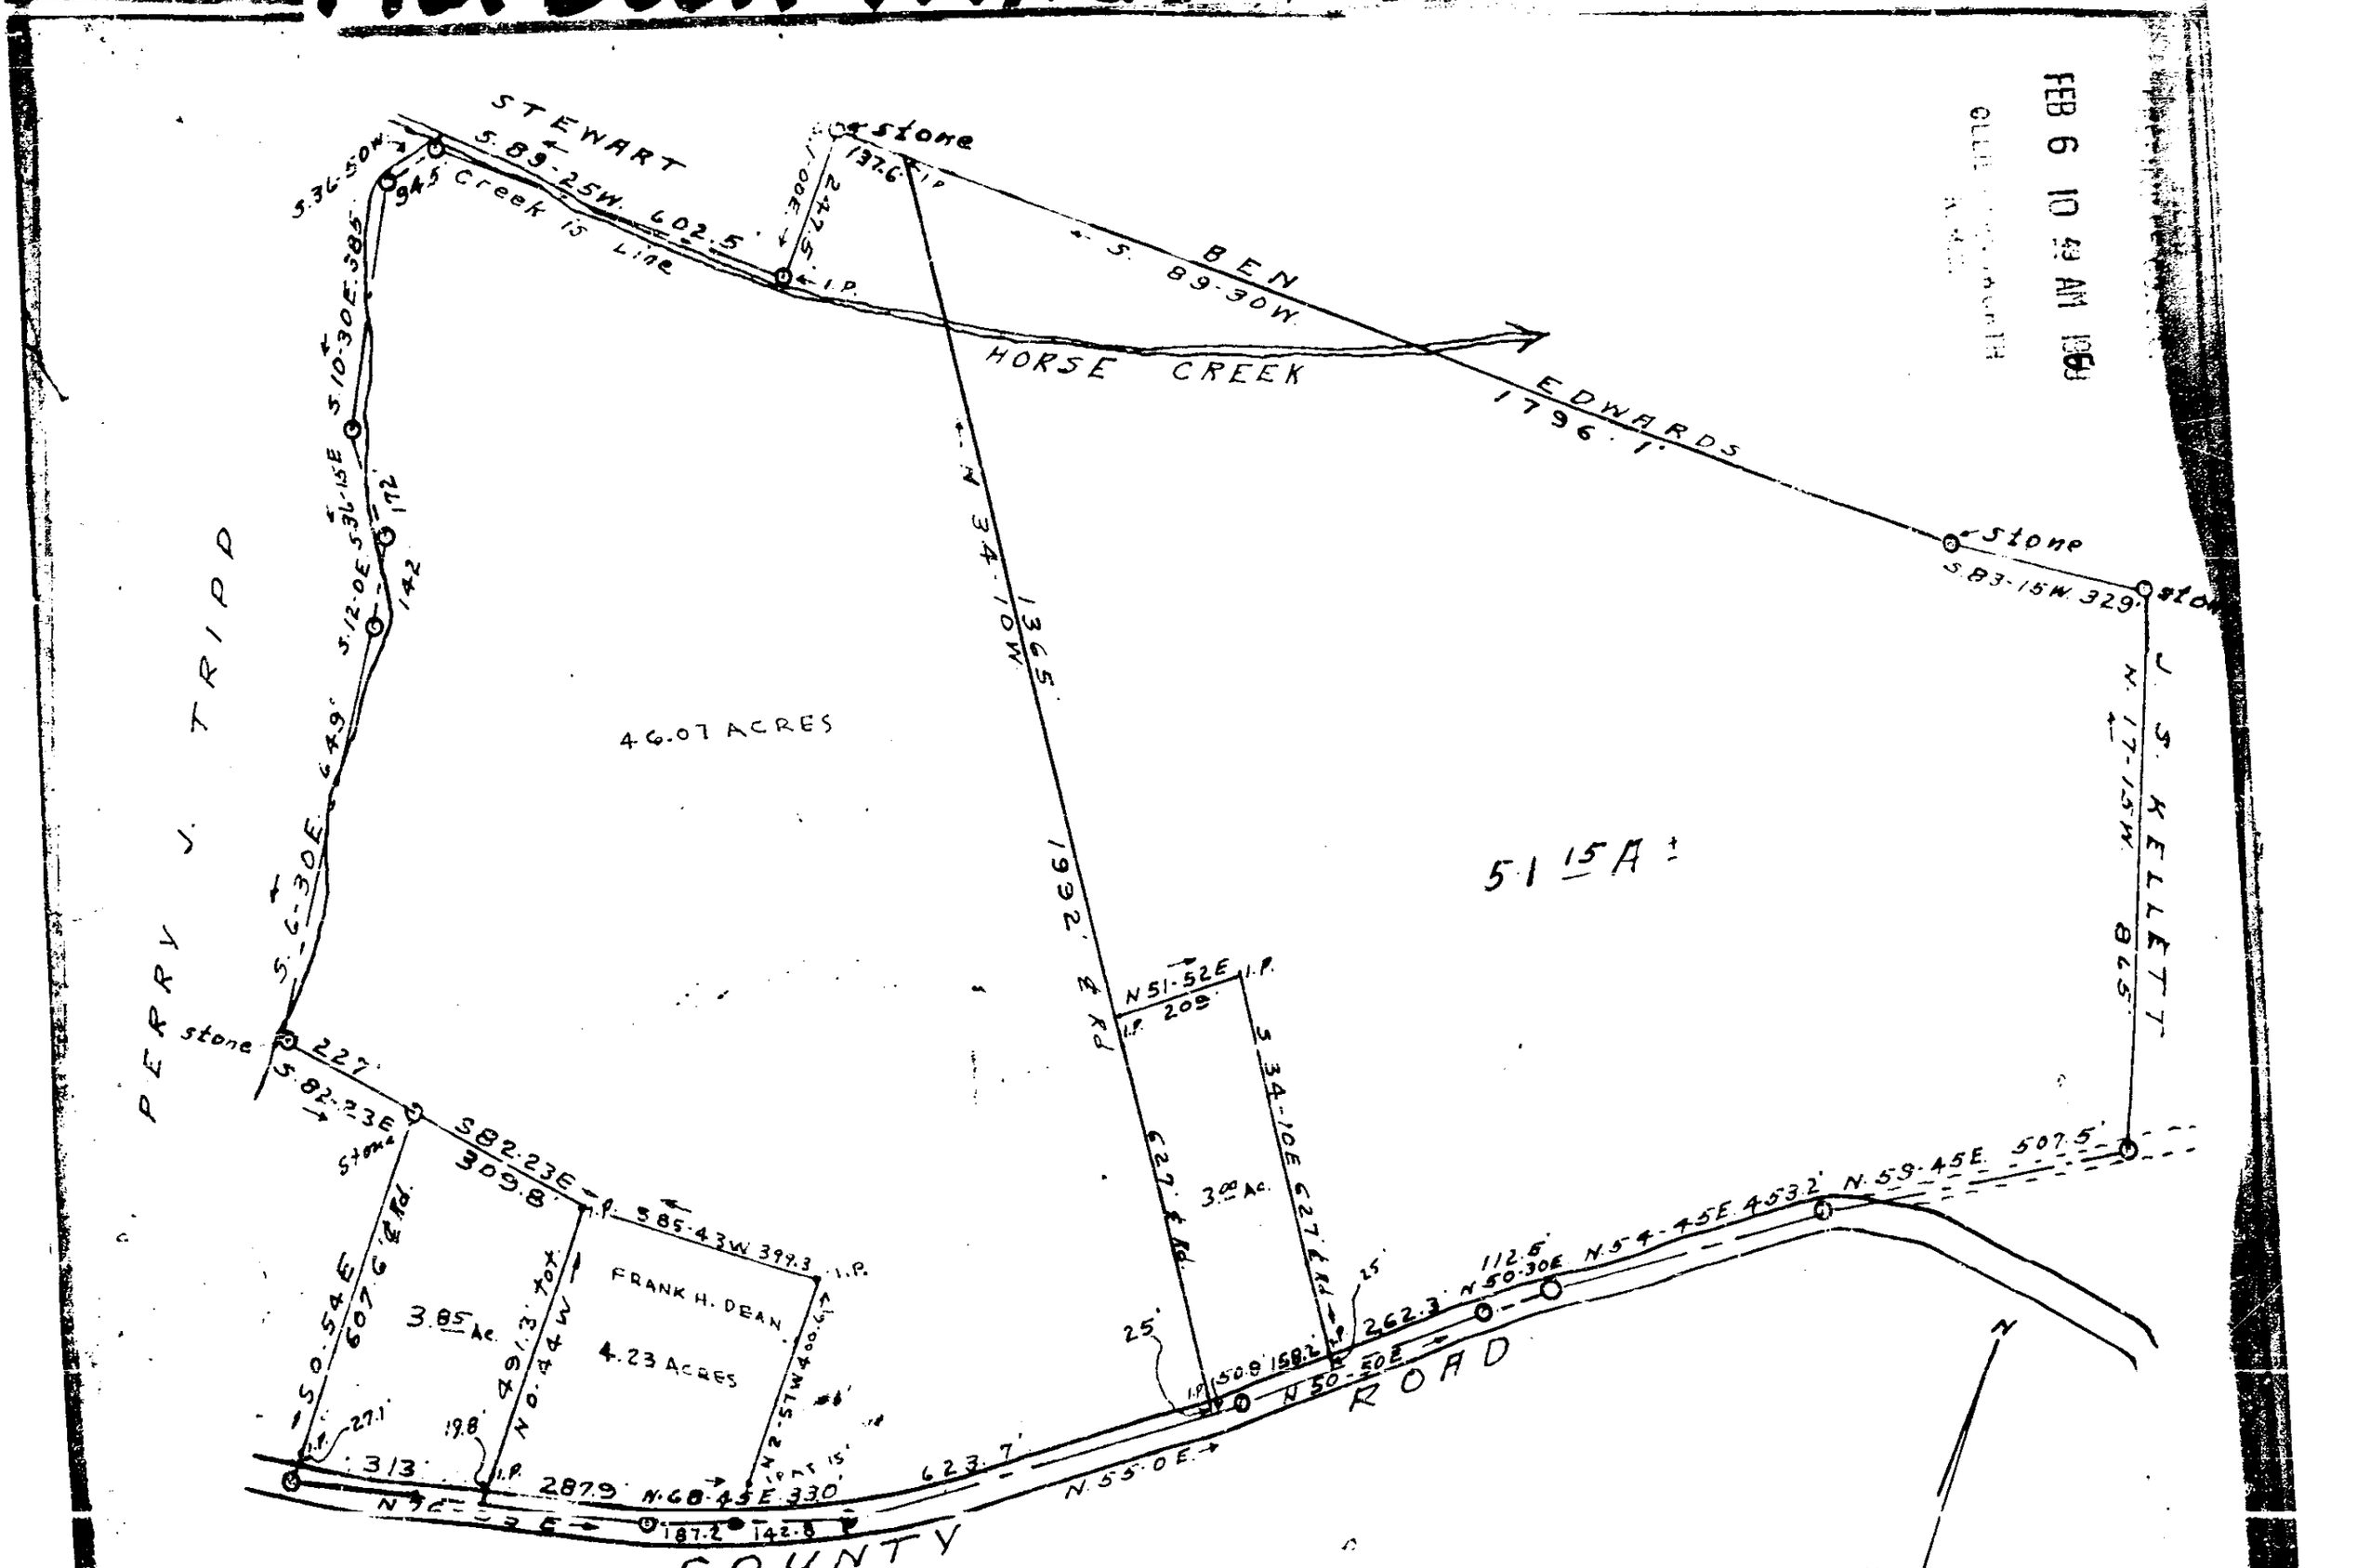

NOTE
4.23 ACRE TRACT
SURVEYED & PLAT
REVISED 1/25/69

NOTE" ~~Dividing line estimated and subject to check by actual survey~~
Dividing line and plat revised 3/11/56
3.85 Acre tract Surveyed and plat revised 10/31/68

PROPERTY OF
J. D. BROWNING AND
FRANK H DEAN
GREENVILLE COUNTY - S. C.
Scale 1" = 300' ------ AUG. 1948
W. J. Riddle - surveyor -

NOTE: 3.00 Acre tract surveyed and plat revised 1/2/63

18681

4A — 43

FEB 6 10 49 AM 1969

#18681 Filed This 6 day of Feb. 1969
And Recorded in Vol. 4A Page 43 at 10:49 M a.
Register Mesne Conveyance Greenville County, S. C.