


21499 Filed This 12 day of Mar. 1969

And Recorded in Vol. 4A Page 111 at 9:30 A.M.

Ollie Farnsworth
Register Mesne Conveyance Greenville County, S. C.

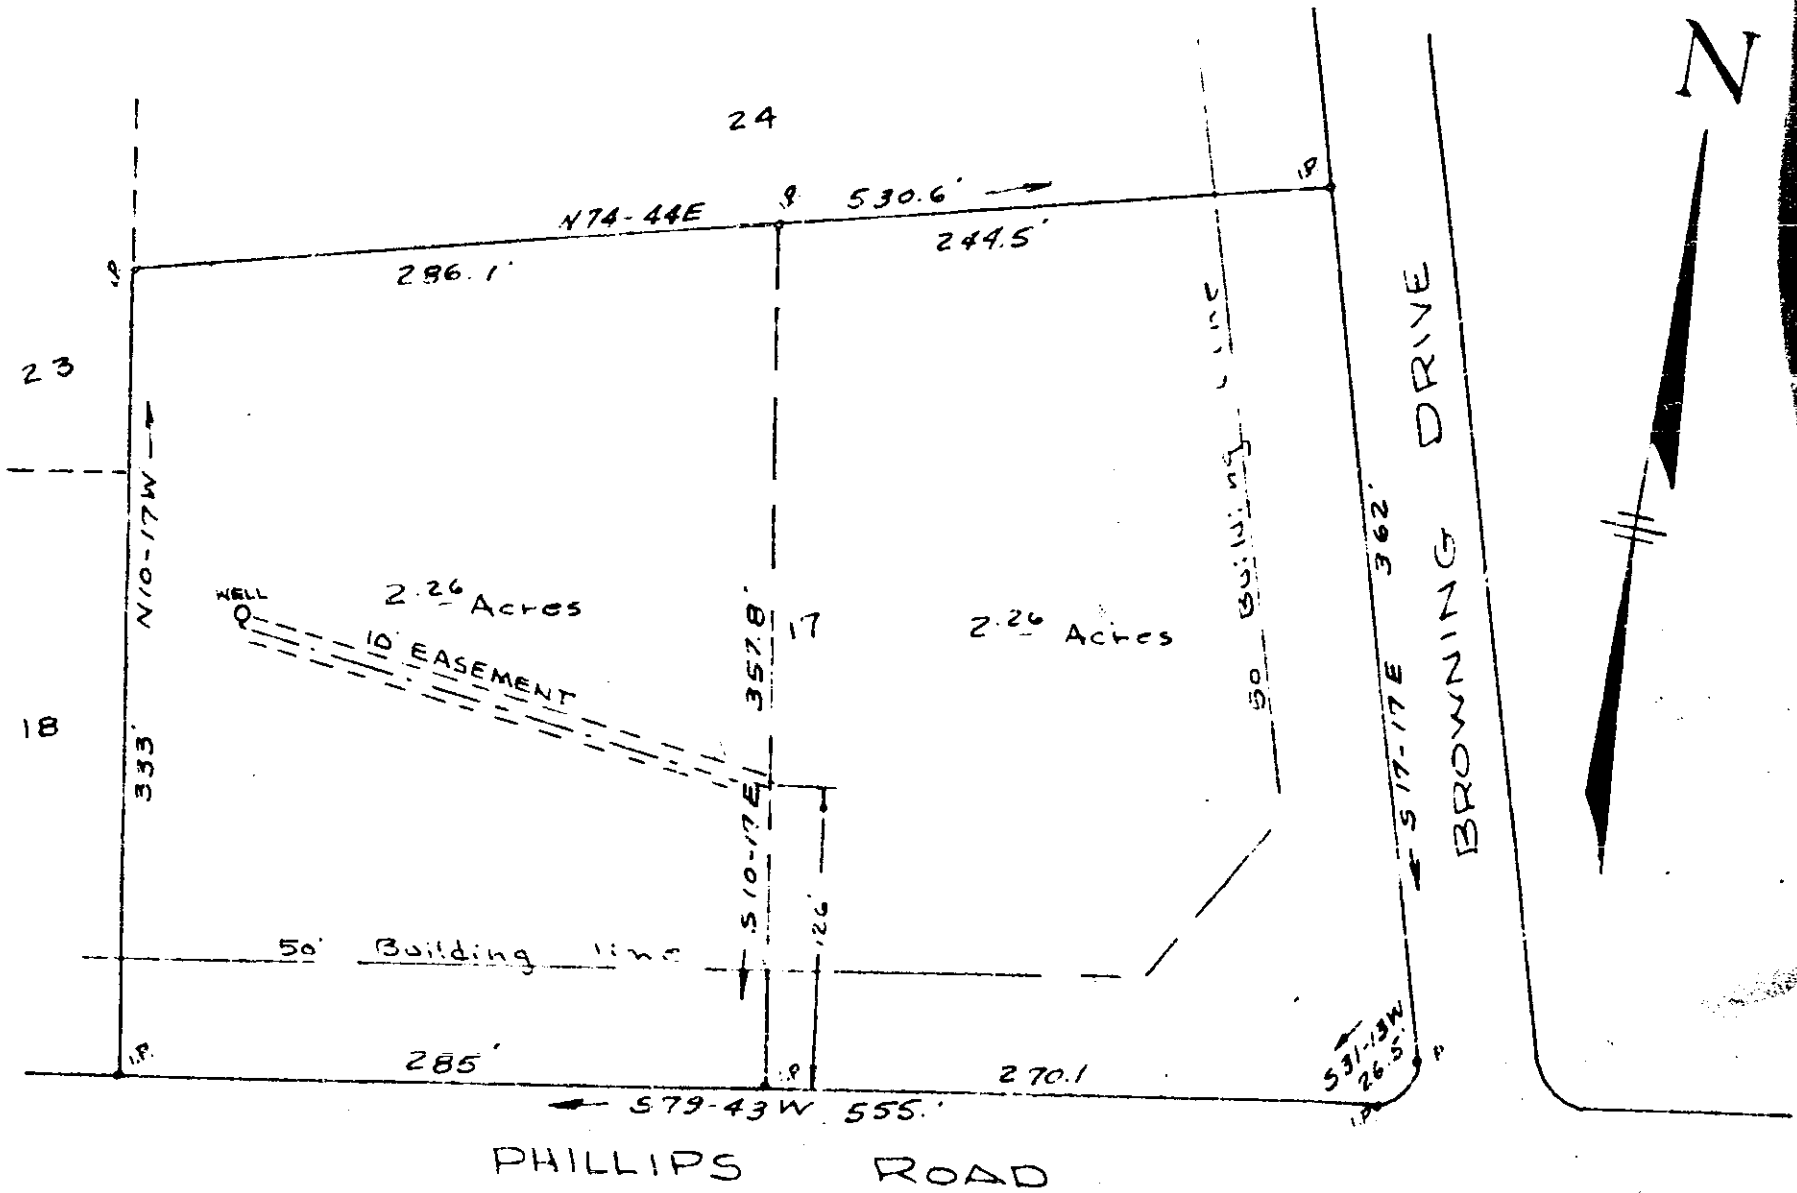

Showing location of Well and 10' Easement across Western-Half of Lot No. 17

March 12, 1969

LOT No 17
BOILING SPRINGS ESTATES
PROPERTY OF
ALVIN C. FINCHER
NEAR GREENVILLE, GREENVILLE CO. S.C.

SCALE 1"=100'

MARCH 19 1968

21499

4A-111

C.P. Kille Rev. L.S. 1347