


22444 Filed This 21 day of March 1969

And Recorded in Vol. 4A Page 125 at 4:41 P.

Ollie Farnsworth

Register Mesne Conveyance Greenville County, S. C.

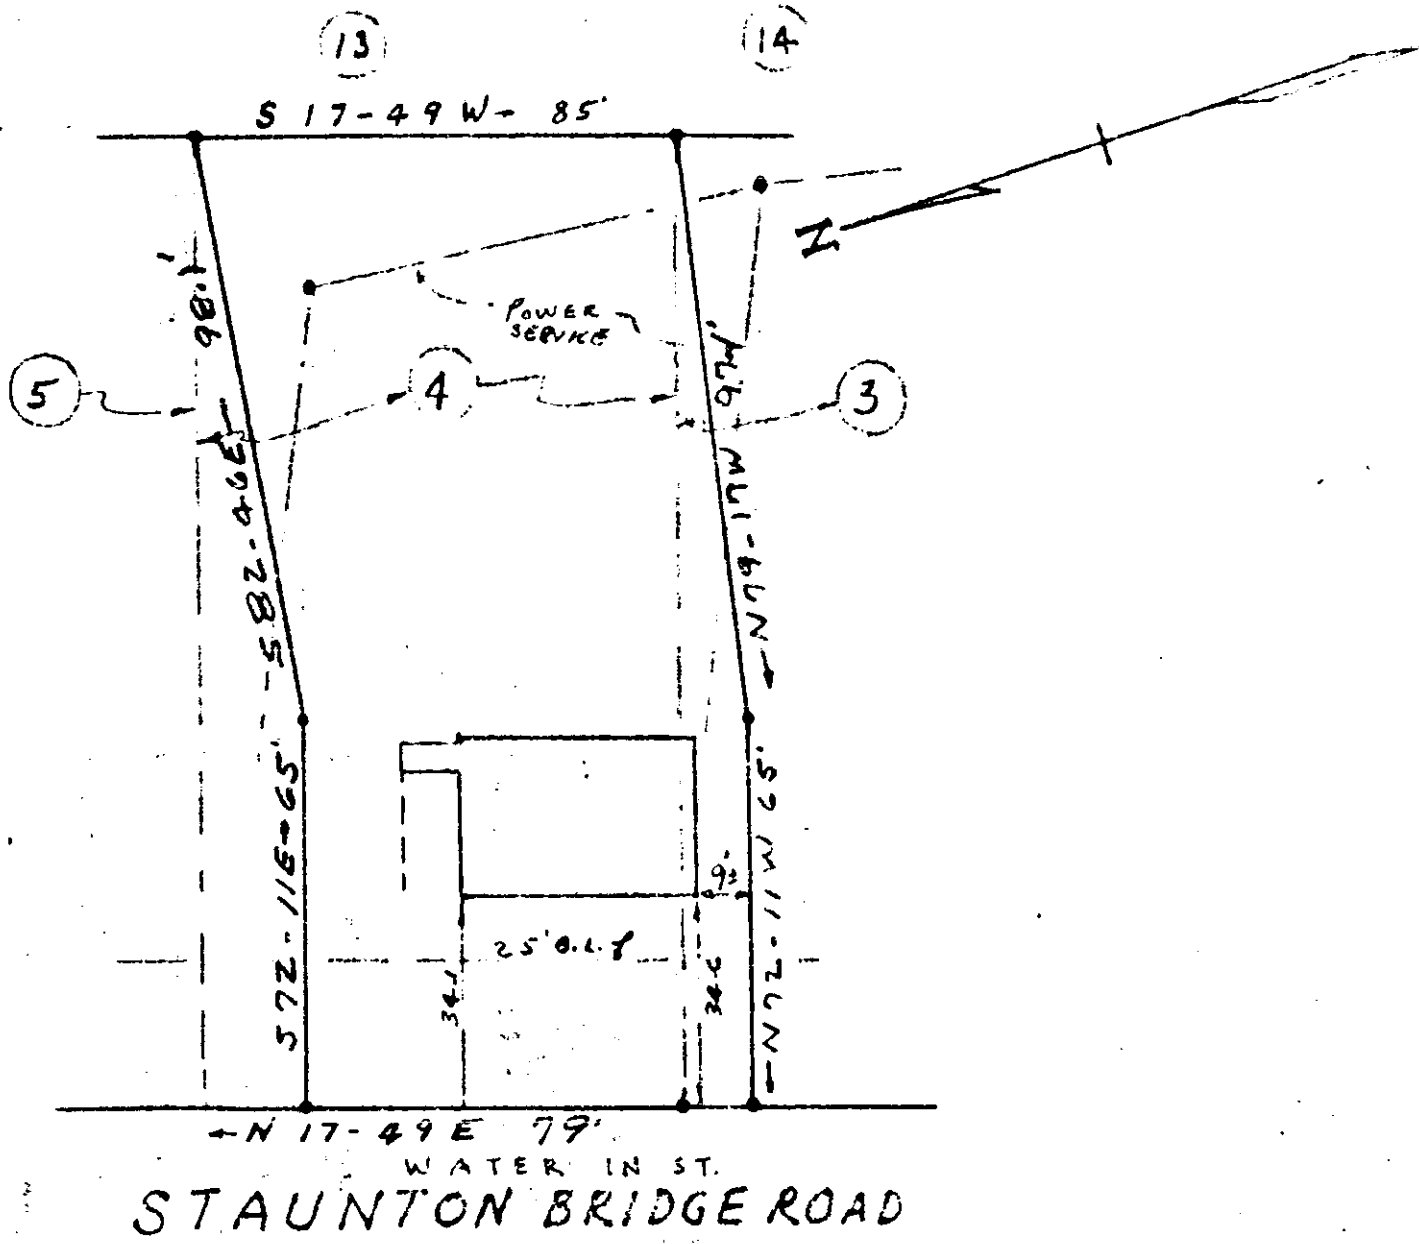

STAUNTON BRIDGE ROAD

PROPERTY OF
MARVIN HURST JR. &
VERNON R. HURST
NEAR GREENVILLE S.C.

22411

SCALE 1" = 40' MAR. 4, 1969

4.A - 125

This is to certify that on March 4, 1969 I surveyed the property shown on this plat, known as the greater portion of Lot No. 4 and a small portion of Lot No. 3 as shown on Plat of Oxford Estates filed in the RMC Office for Greenville Co. in Plat Book Wat page 158, and that the property lines, walls and building are as shown hereon, and that the building located on said lot does not project nor encroach on adjacent streets or property, and that no adjacent walls or buildings project nor encroach on said lot, and that no utility lines cross this lot except as shown hereon.

Survey by Campbell & Clarkson
Surveyors, Inc.
H.C. Clarkson Jr.
S.C.S.S. No. 2539

FILED
GREENVILLE CO. S.C.
MAR 21 4 41 PM '69
OLLIE FARNSWORTH
R.M.C.