24777 Filed This 16 day of April 1969

And Recorded in Vol. 4A Page 181 at 10:27 A.M.

Ollie Farnsworth

Register Mesne Conveyance Greenville County, S. C.

FILED
GREENVILLE CO. S. C.
APR 16 10 27 AM '69
OLLIE FARNSWORTH
R.M.C.

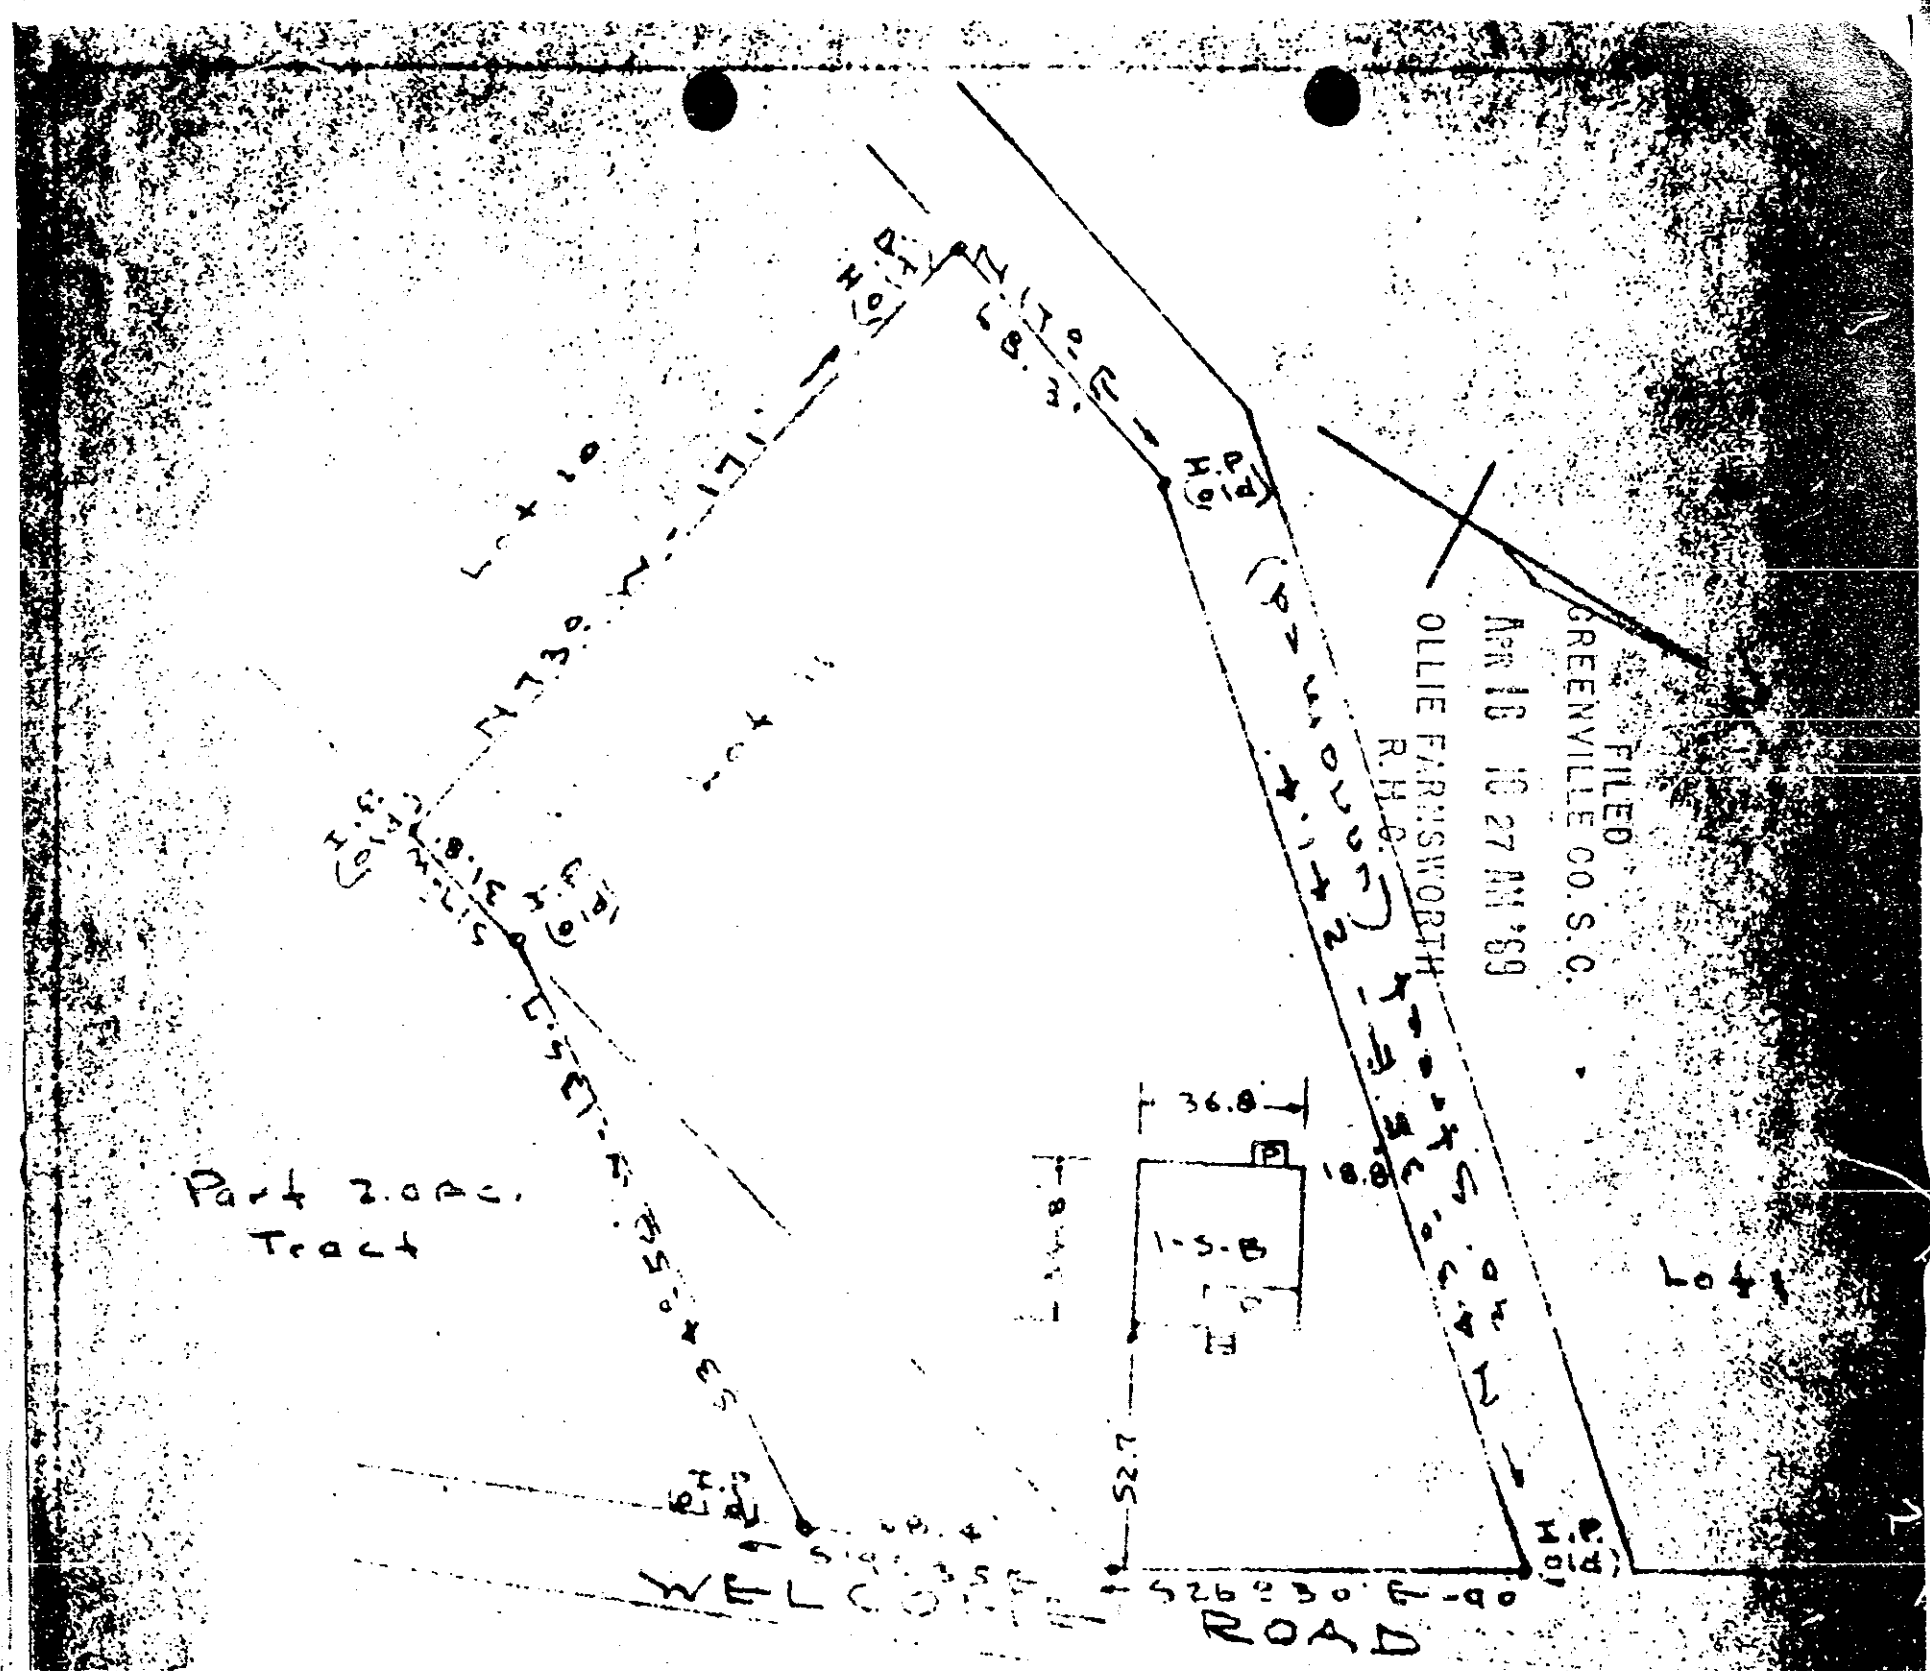

PROPERTY OF
WILLIAM A. HAMMOND

Lot 11- J.E. Strickland & Part 2.0 Ac. Tract - William A. Hammond
Near Greenville, S.C.
Scale 1" = 50' - Dec. 6 - 1954

This is to certify that on the 6th. day of December, 1954, I surveyed the property shown hereon, being known as lot No. 11--unrecorded plat of J.E. Strickland, and part of a 2.0 acre tract of William A. Hammond, and that the property lines, walls and buildings are as shown hereon; that the buildings located on said lot do not encroach on project on adjacent streets or property, and that no adjacent buildings, or walls, encroach or project on said premises.

4A-181

2177

Registered Land Surveyor

BAD COPY