
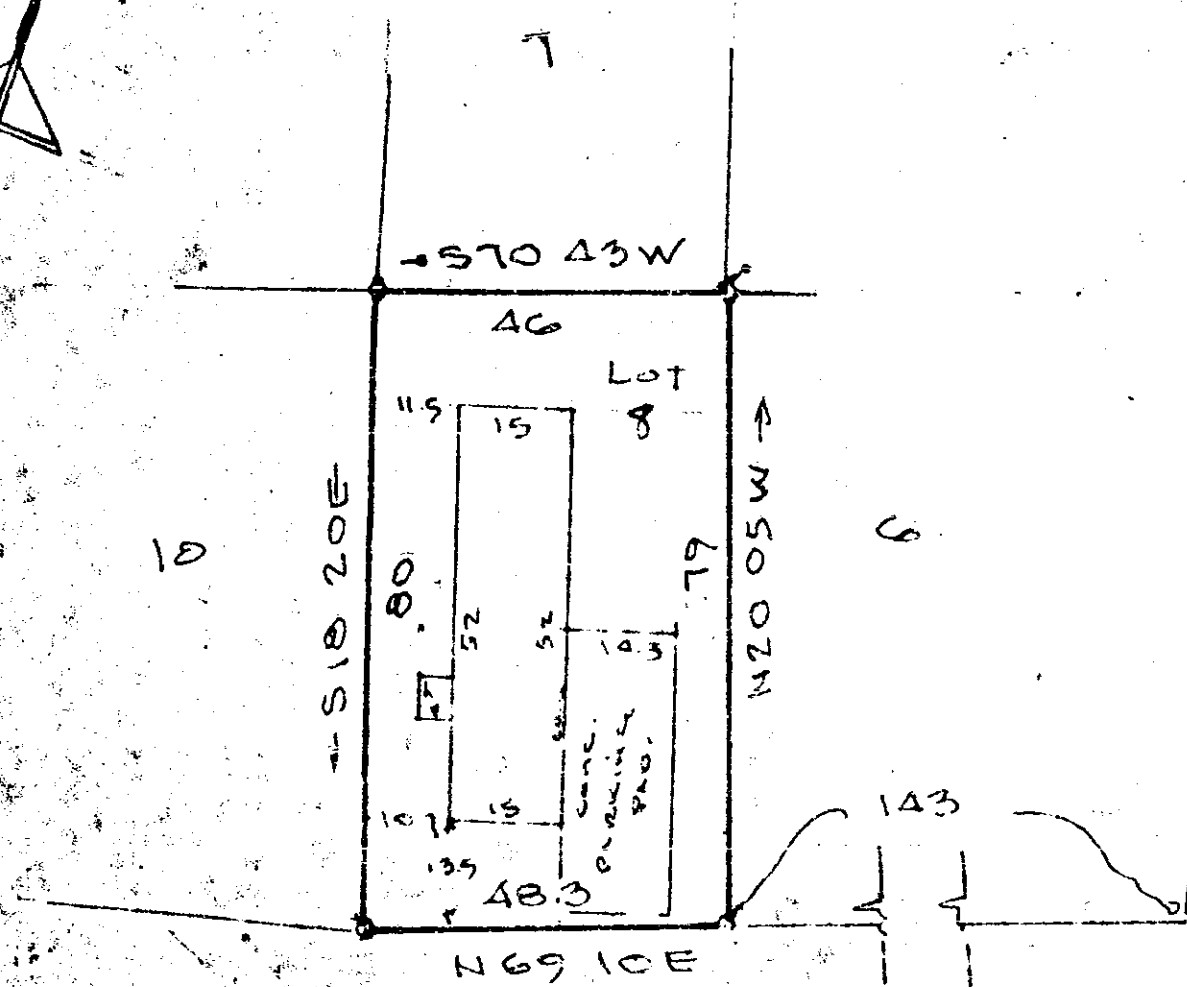


26531 Filed This 6 day of May 1969

And Recorded in Vol. 4A Page 183 at 3:56 P.M.

Ollie Farnsworth

Register Mesne Conveyance Greenville County, S. C.

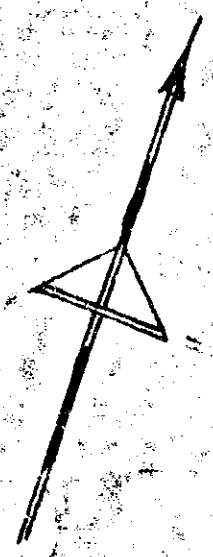

FORNER ST

OAK DR

FILED
GREENVILLE CO. S. C.
MAY 6 3 56 PM '69
OLLIE FARNSWORTH
R.M.C.

4A - 183

26531

PROPERTY OF

BOBBY ERNEST KING

GREENVILLE COUNTY S.C.

Scale 1" = 30' APR 10 1969




183