


DUNCAN CHAPEL FIRE DISTRICT

SCALE
1" = 800'
PREPARED BY
GREENVILLE COUNTY PLANNING COMMISSION
revision 46-41

Microfilmed

46-121

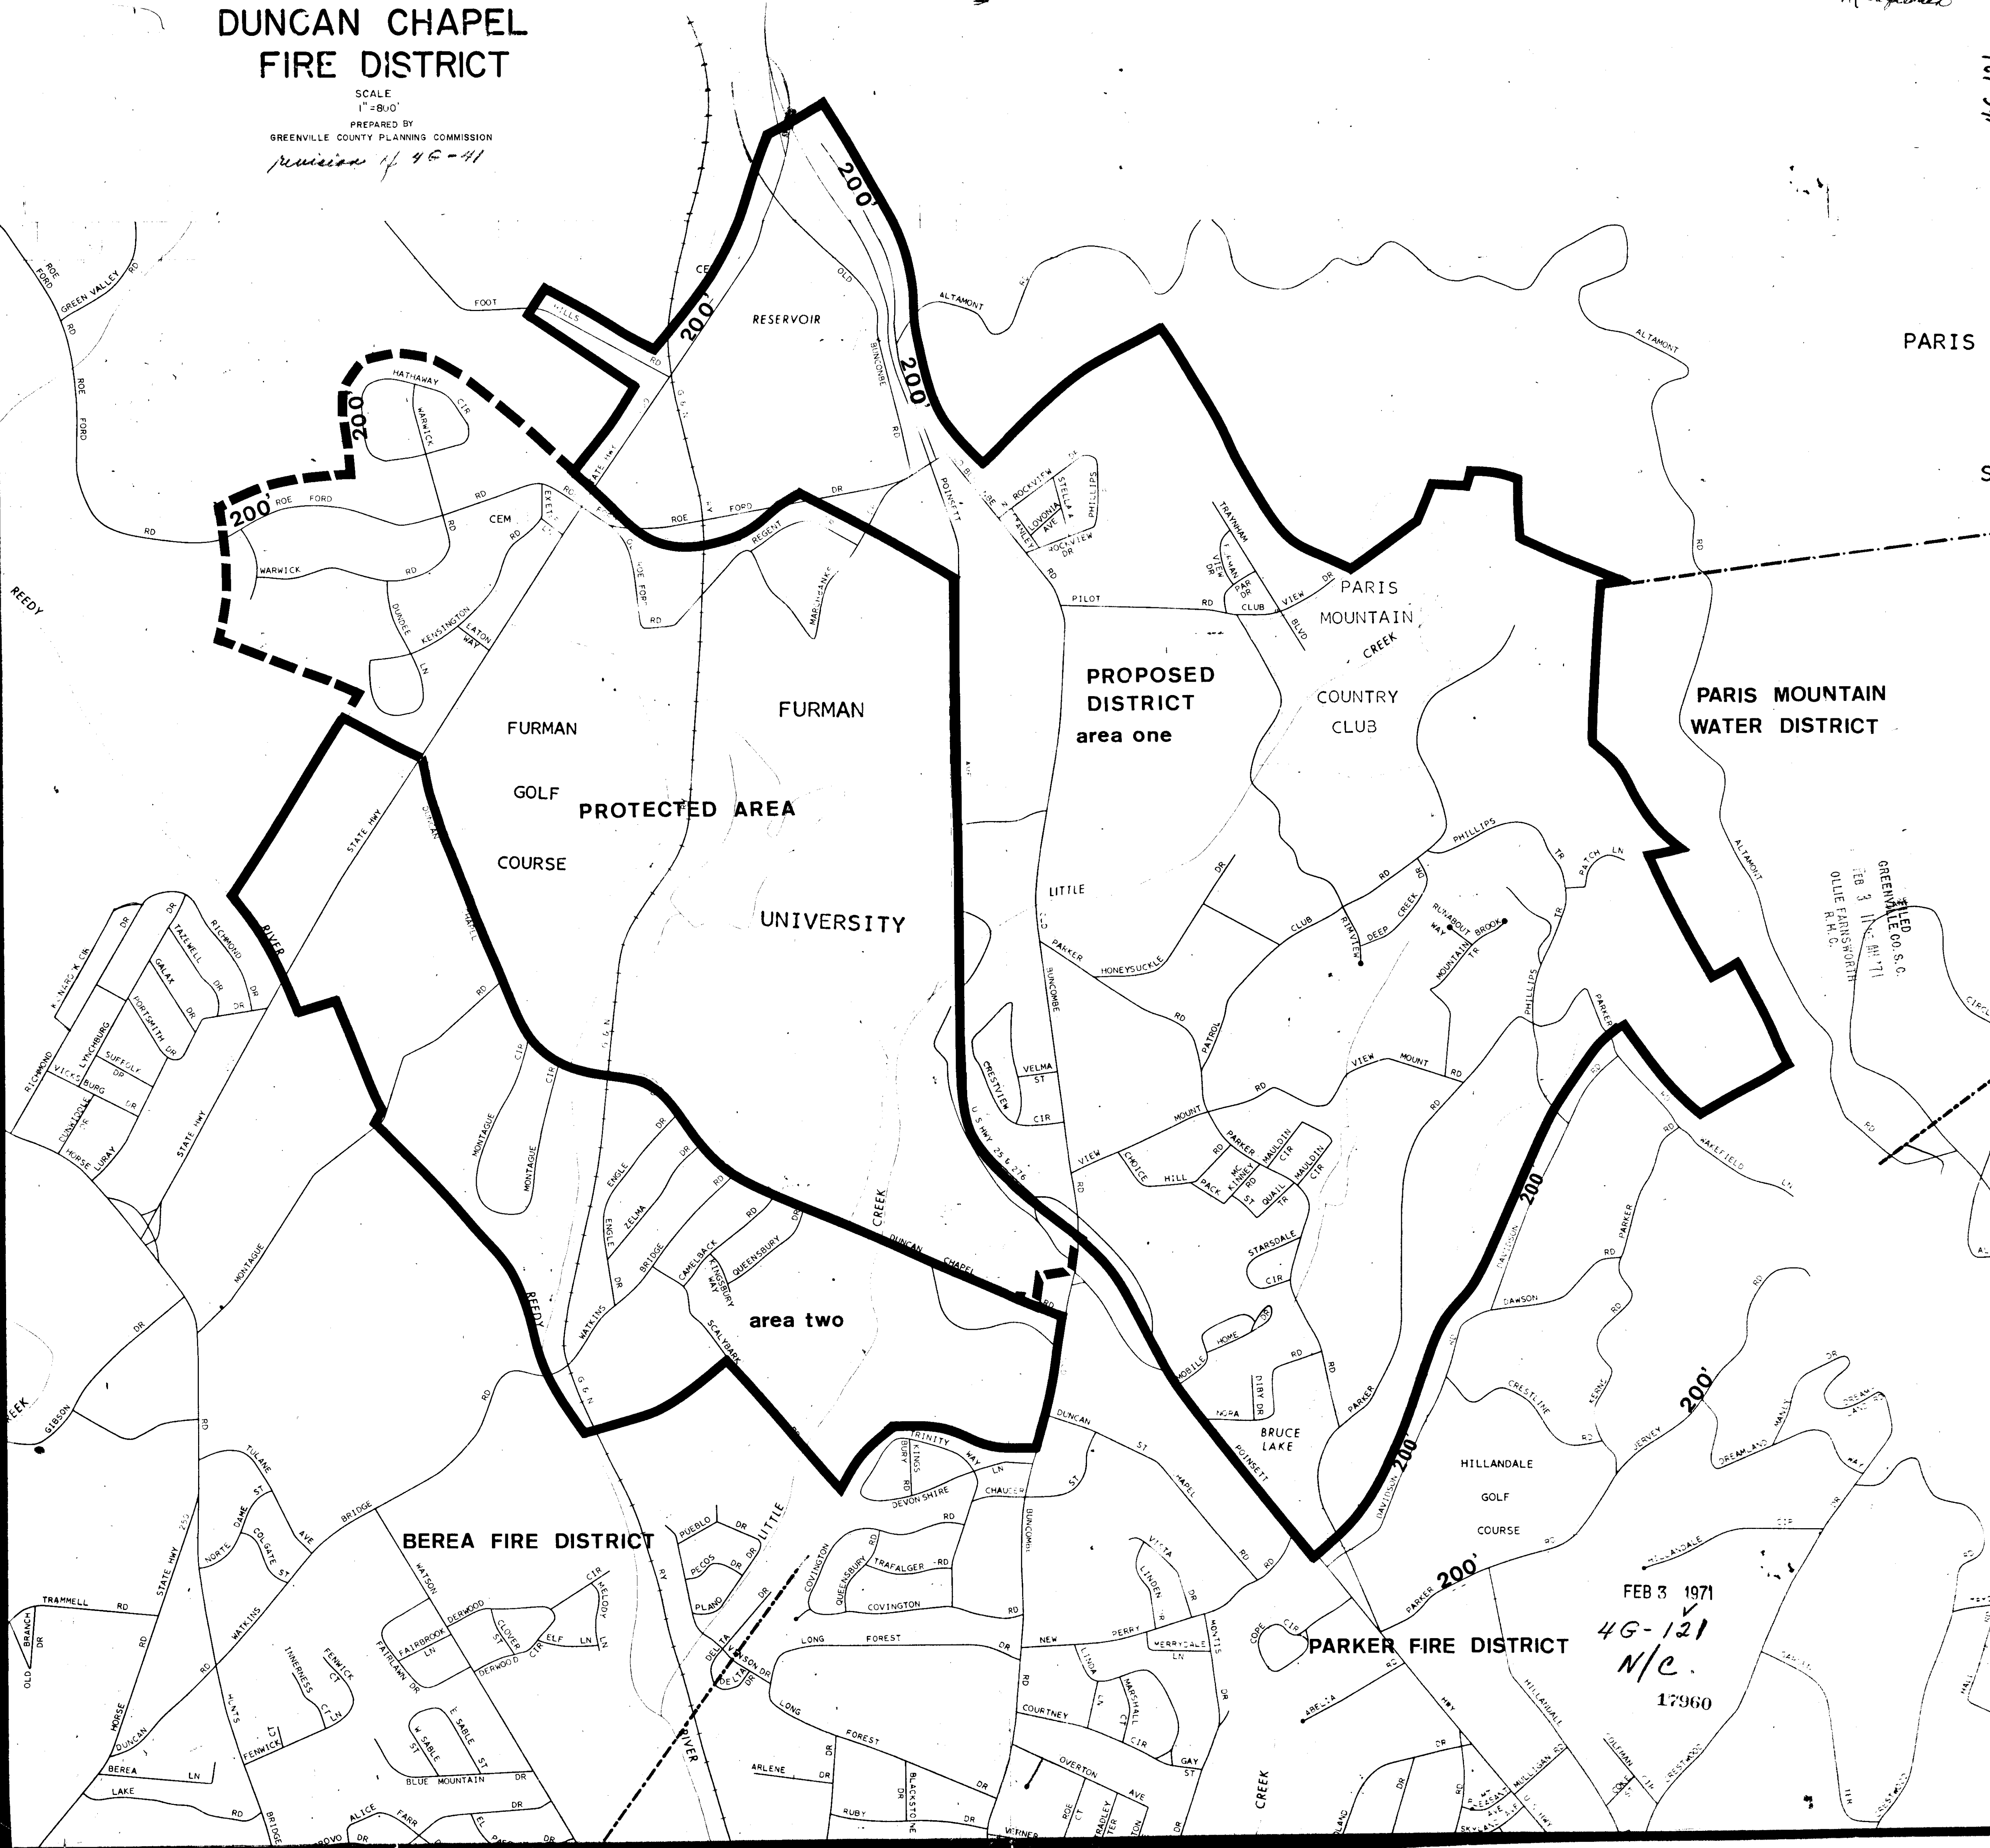

FILED
GREENVILLE CO. S.C.
FEB 3 11:24 AM '71
OLLE FARRS-NORTH
R.H.C.

FEB 3 1971
46-121
N/C.
17960