


-GILLIS-

FILED
GREENVILLE CO. S. C.
MAY 12 3 01 PM '71
OLLIE FARNSWORTH
R.M.C.

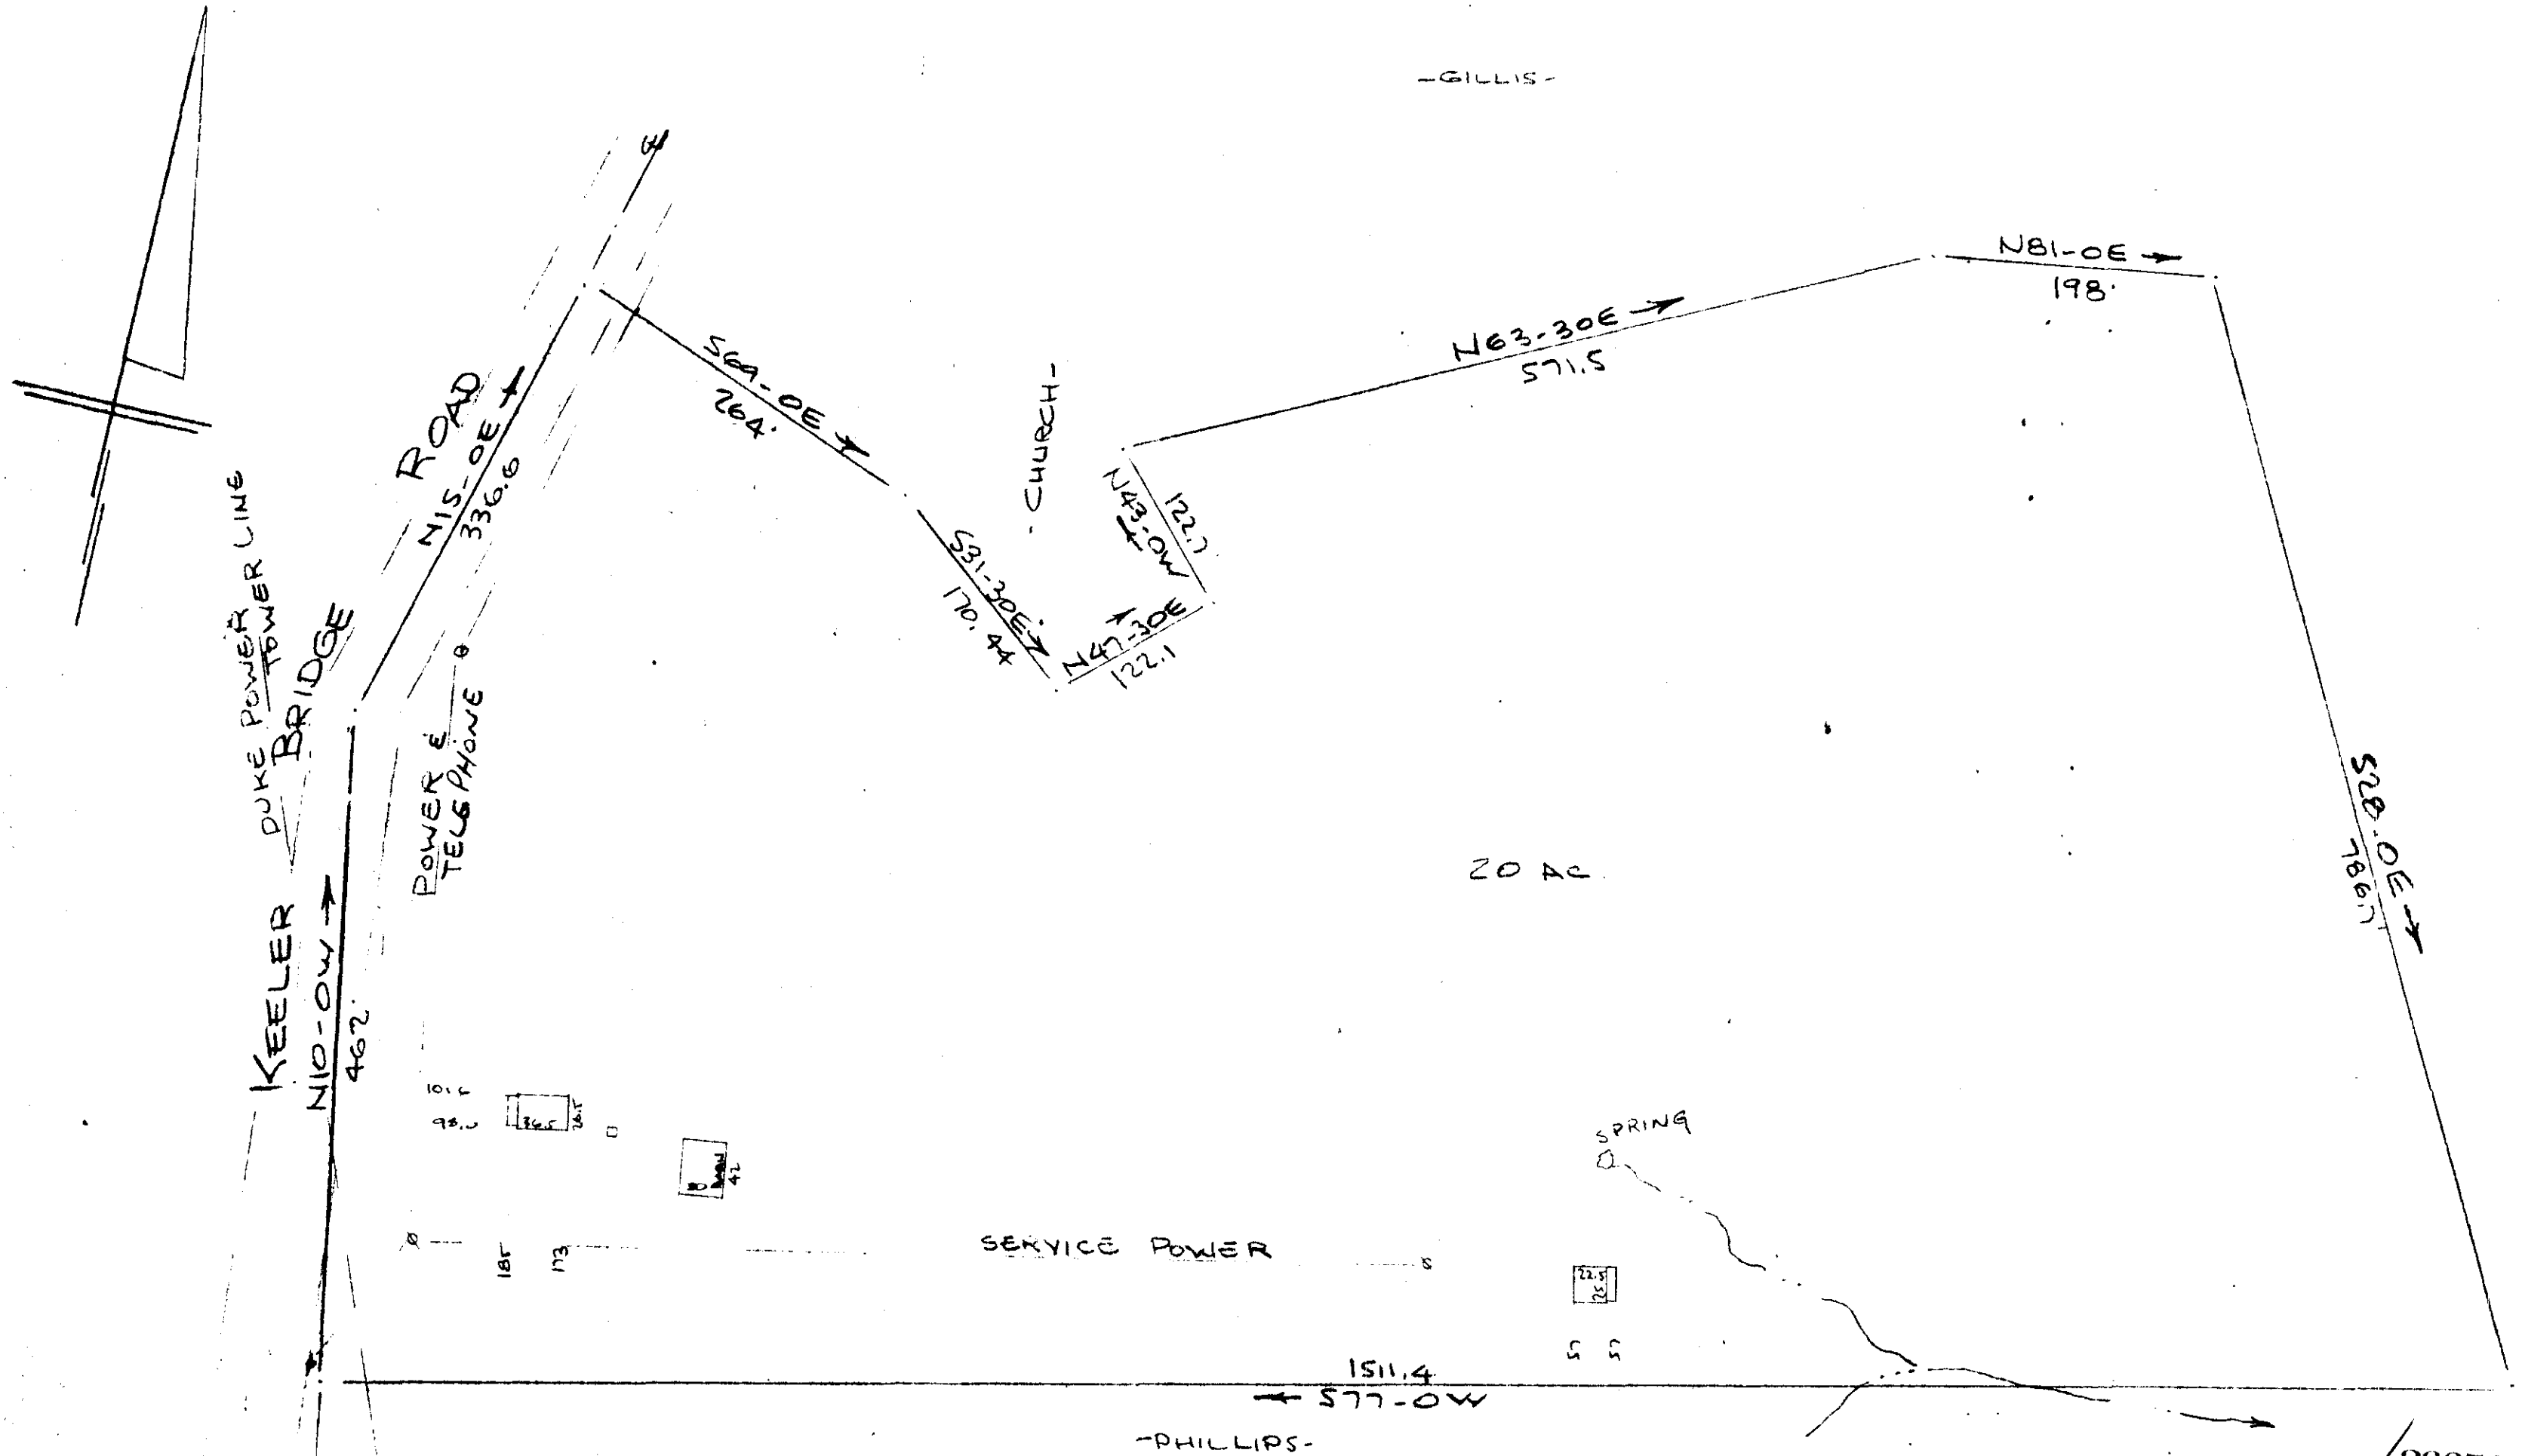

-PHILLIPS-

26654
46-141

This is to certify that on the 15th day of May 1971, I surveyed the property shown on this plat, being known as PROPERTY OF MARVIN DANIEL HUDSON and recorded in the REC Office Greenville, South Carolina, in Plat Book _____ of Page _____ and that the property lines, walls and buildings are as shown hereon, and that the walls and buildings located on said property do not encroach on adjacent streets or easements, and that no adjacent walls or buildings encroach on property of said applicant, and no power lines or other property, except as shown hereon.

F. R. [Signature]

PROPERTY OF
MARVIN DANIEL HUDSON
NEAR GREENVILLE, S. C.
SCALE: 1" = 100' MAY 1971
CAROLINA SURVEYING CO
GREENVILLE, S. C.