
And Recorded in Vol. 4.4 Proc. ___ at all 42 M. Ollie Fasses Street County, S. C.

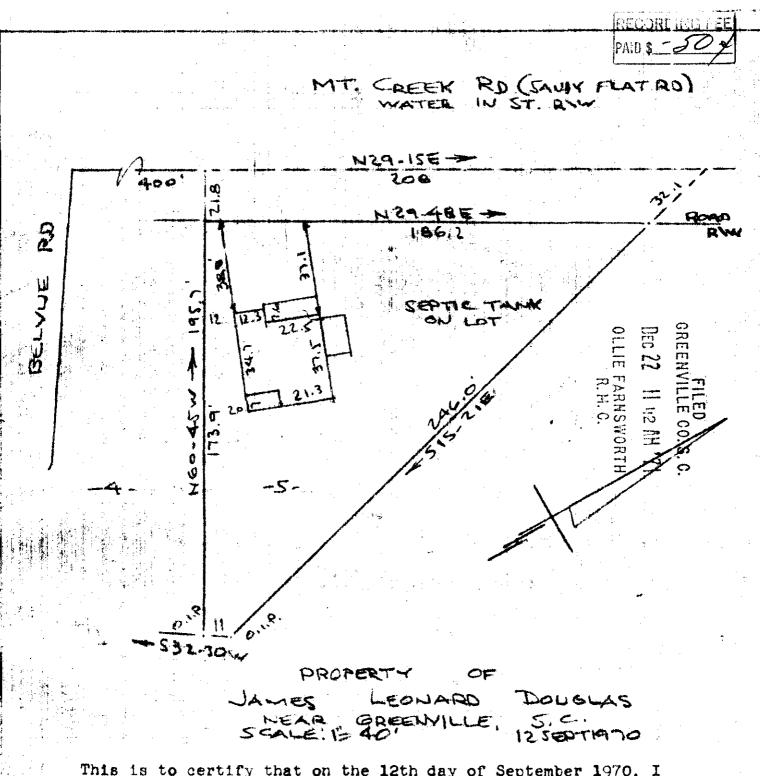

This is to certify that on the 12th day of September 1970, I surveyed the property shown on this plat, being known as lot 5 on plat of PROPERTY OF JAMES LEONARD DOUGLAS and recorded in the RMC Office Greenville County, S.C., in Plat Book \| \| at Page () ; and that the property lines, walls and buildings are as shown hereon, and that the walls and buildings located on said lot do not encroach or project on adjacent street or property, and that no adjacent walls or buildings encroach or project on said premises, and no power lines cross this property except as shown hereon.

44-1

R. B. Bruce, R.L.S. #1952

17193

CAROLINA ENGINEERING & SURVEYING CO. Greenville, South Carolina