Plat Book 4H, Page 139 B

#14199 Filed This 16 day of Dec. 1971
And Recorded in Vol. 4H Page 139 at 4:39 P.M.
Ollie Farnsworth
Register of Deeds for Greenville County, S. C.

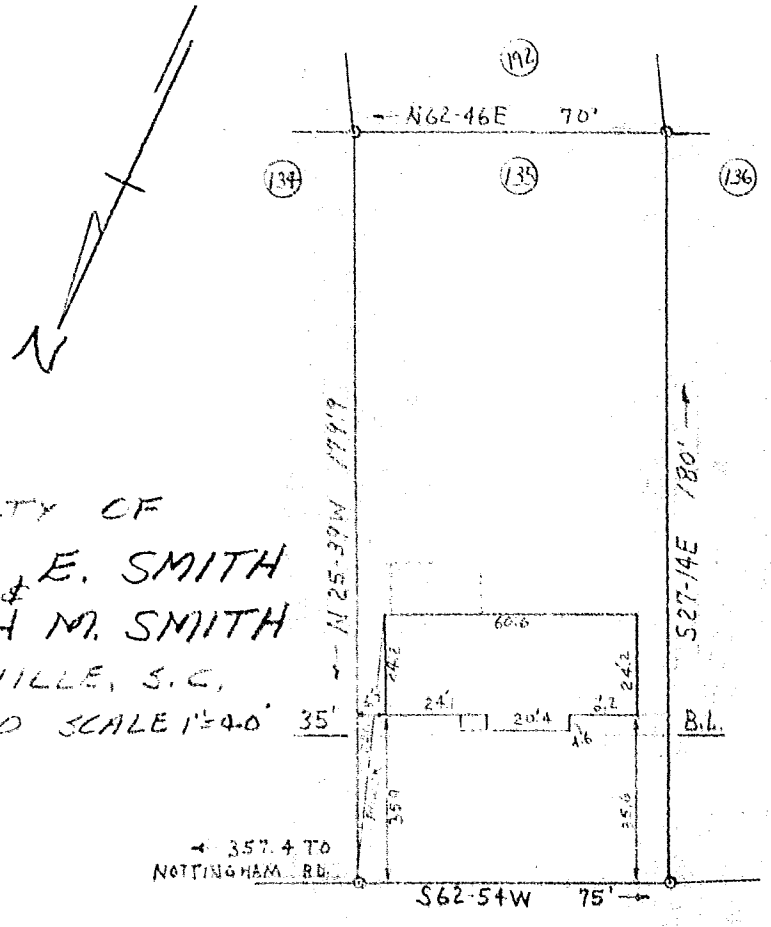

PROPERTY OF
CHARLES & E. SMITH
ELIZABETH M. SMITH
GREENVILLE, S.C.
DEC. 8, 1970 SCALE 1"=40'

DEC. 11 4:39 P.M. '71
ELLIE FARNSWORTH
R.M.C.

This is to certify that on Dec. 8, 1970 I surveyed the property shown on this plat, known as Lot No. 135 of Sherwood Forest as shown on a plat recorded in the RMC Office for Greenville Co. in Plat Book B.B. at pages 30 - 31, and that the property lines, walls and building are as shown hereon, and that the building located on said lot does not project nor encroach on adjacent streets or property, and that no adjacent walls or buildings project nor encroach on said lot, and that no utility lines cross this lot except as shown hereon.

Survey by Terrell L. Clarkson
Surveyors, Inc.
H. C. Clarkson, Jr.
..... No. 2510

4H-139
DEC. 11, 1970
14199