


Plat Book 4H, Page 143A

#13831 Filed Nov 11 day of Nov 1970
 And Recorded in Vol. 4H Page 143 at 2:01 P.M.
Ollie Farnsworth
 Register Marine Conveyance Greenville County, S. C.

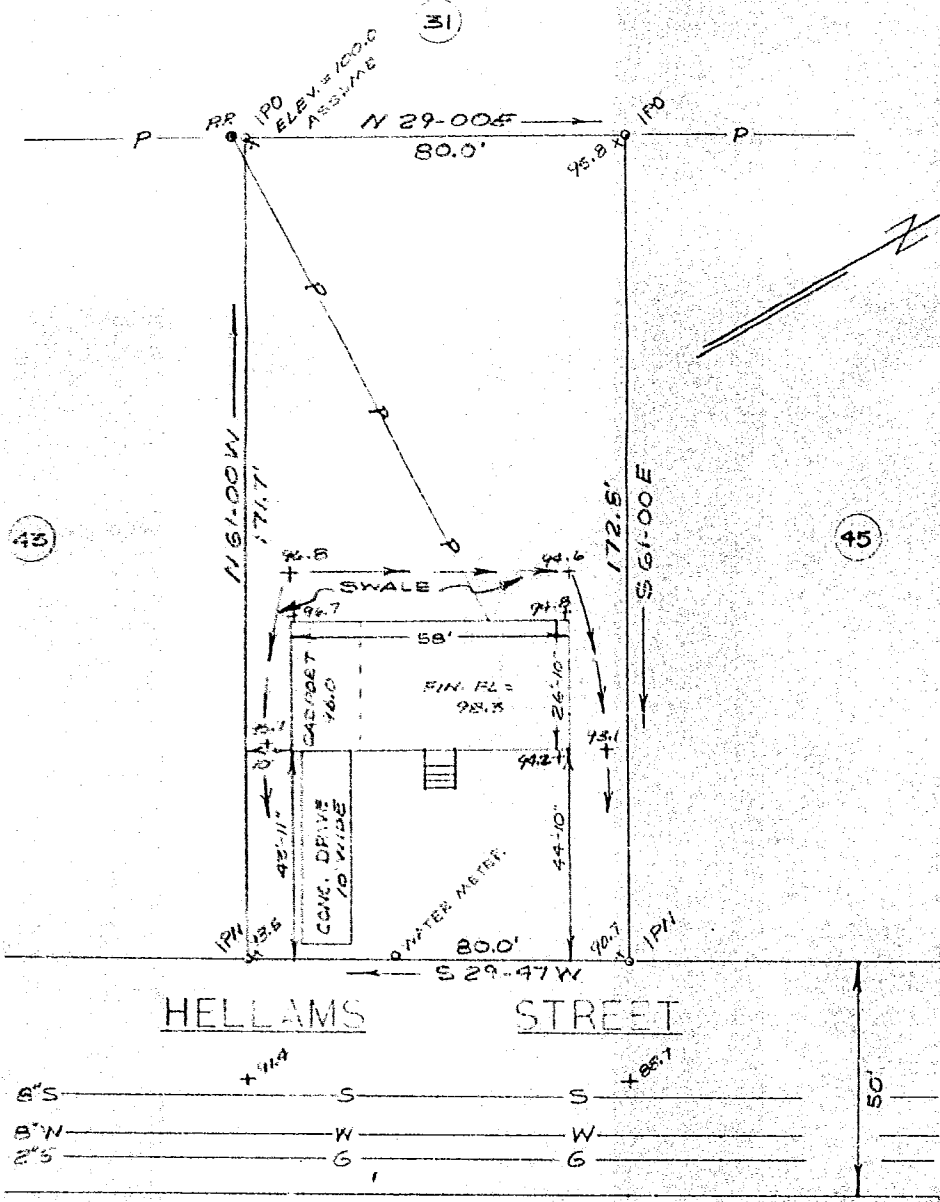

PLAT OF PROPERTY OF
DAVID H. GARRETT ✓
 Lot 44 Friendship Heights
 1 mile Northeast of Fountain Inn
 Greenville County South Carolina
 Scale: 1" = 30' November 27, 1970

GREENVILLE CO., S. C.
 DEC 11 2 01 PM '70
 OLLIE FARNSWORTH
 R.M.C.

This is to certify that on this date, the lot shown above was surveyed by me; and that property lines, walls, and buildings are as shown; that the buildings located on said property do not project or encroach on adjacent streets or property; and that no adjacent buildings or walls encroach on said premises.

J. E. Woods DEC 11 1970 4H-143
 John E. Woods R. L. S. #3980 13831

RECORDING FEE
 PAID \$ 50⁰⁰