


15996 Filed This 11 day of Jan. 1971
 And Recd. in R.M.C. 4 H. 193 3.26 M.
 Ollie Farnsworth
 Register of Deeds Greenville County, S. C.

50' CONNECTICUT AVENUE
 (ROBINSON STREET)

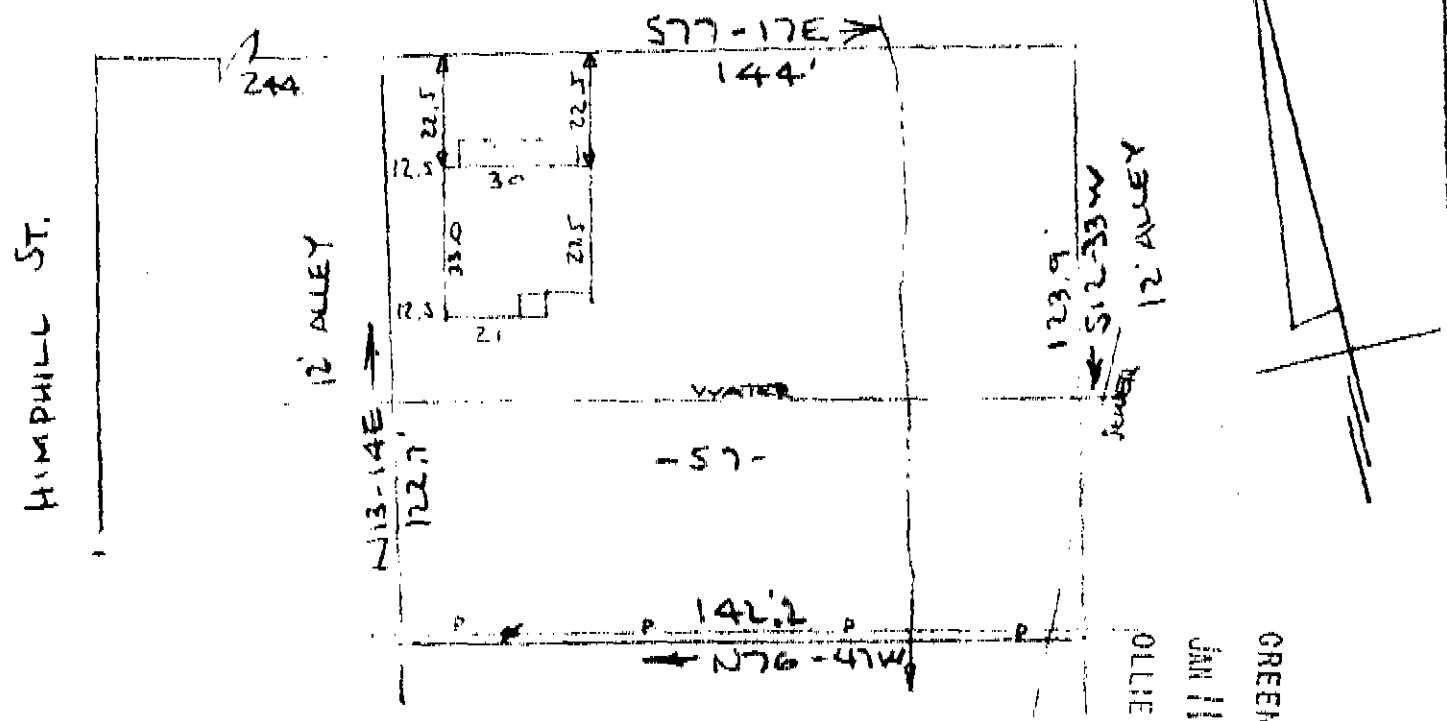

PROPERTY OF
 JAMES R. BOULAR & NORMA J. BOULAR
 GREER, S. C. - GREENVILLE CO
 SCALE: 1" = 40'
 4 JAN 1971

FILED
 GREENVILLE CO. S. C.
 JAN 11 3 26 PM '71
 OLLIE FARNSWORTH
 R.M.C.

This is to certify that on the 4th day of January 1971, I surveyed the property shown on this plat, being known as lot 57 on plat of Subdivision of GREER MILL VILLAGE and recorded in the RMC Office Greenville County, S. C., in Plat Book "Y" at Pages 138 & 139; and that the property lines, walls and buildings are as shown hereon, and that the walls and buildings located on said lot do not encroach or project on adjacent street or property, and that no adjacent walls or buildings encroach or project on said premises, and no power lines cross this property except as shown hereon.

R. B. Bruce
 R. B. Bruce, RLS #1952
 ✓ AH-193 JAN 11 1971

CAROLINA SURVEYING COMPANY
 Greenville, S. C.

15996