


# Plat Book 4H, Page 199 B

#16551 Filed This 18 day of Jan. 1971  
And Recorded in Vol. 4H Page 199 at 1:24 P.  
Ollie Farnsworth  
Register Mesne Conveyance Greenville County, S. C.

HB-151  
HB-150

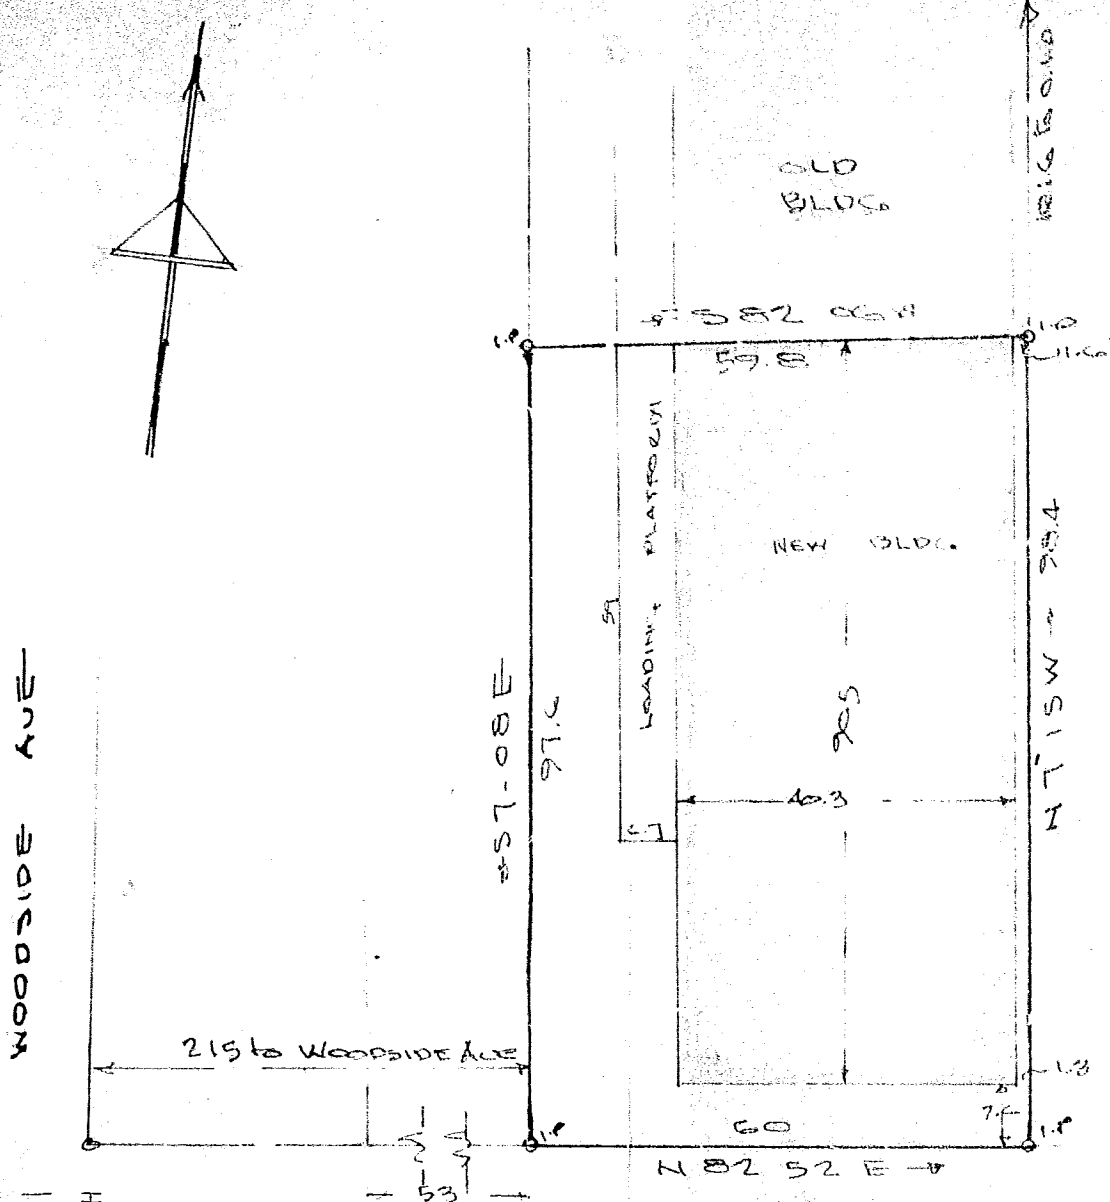

FILED  
GREENVILLE CO. S. C.  
JAN 18 1 24 PM '71  
OLLIE FARNSWORTH  
R. M. C.

16551

JAN 18 1971

BRAMLETT RD

PROPERTY OF

DOUGLAS L. MOODY

GREENVILLE COUNTY S.C.

Scale 1"=20' MAY 14-1970

4H-199

RECORDING FEE  
PAID \$ 50<sup>00</sup>

JONES ENGINEERING SERVICE

