


MICROFILMED

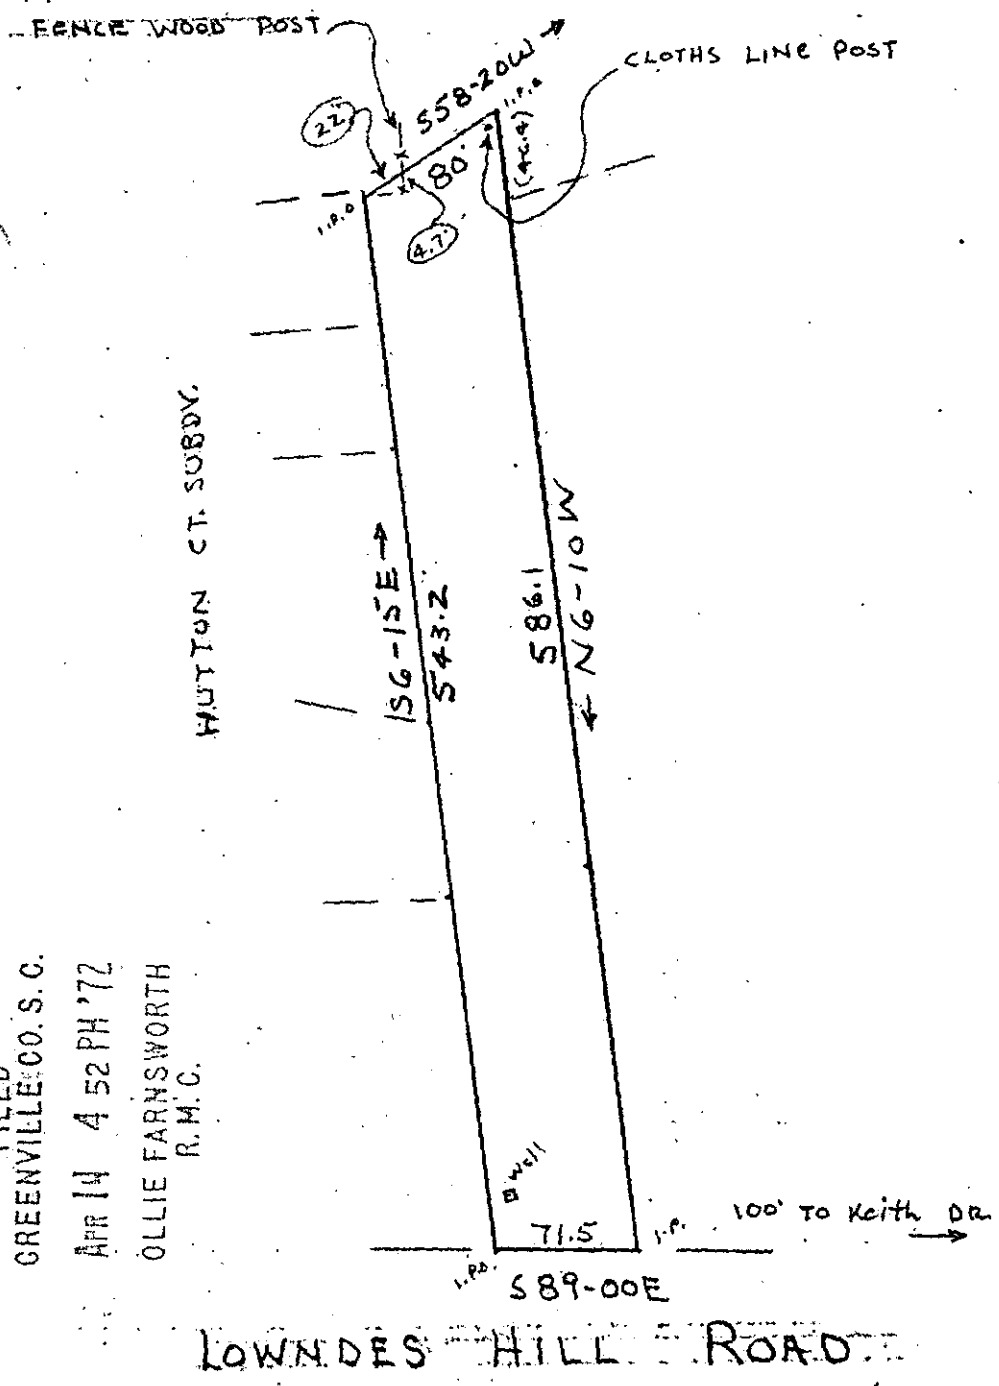

FILED
GREENVILLE CO. S. C.
APR 14 4 52 PM '72
OLLIE FARNSWORTH
R.M.C.

LOWNDES HILL ROAD

27918

APR 14 1972
40-27

I hereby certify that on March 10, 1972 I surveyed the above lot, described by deed recorded in Vol. 503 on page 482 in the R.M.C. Office Of Greenville County; and that the property lines, buildings, and walls are as shown hereon, that no walls or buildings encroach or project on adjacent streets or property and no buildings or walls encroach or project on these premises except as shown.

Charles F. Webb
Charles F. Webb R.L.S.

PROPERTY OF
DONALD F. WAGGONER
IN THE CITY OF GREENVILLE
GREENVILLE COUNTY SC.
WEBB SURVEYING & MAPPING CO.
SCALE 1"=100' MAR. 10, 1972