


MICROFILMED

BUNCOMBE ST.
WATER & SEWER IN ST. R.W.

GREEN (CORNELIA) ST.
WATER & SEWER IN ST. R.W.

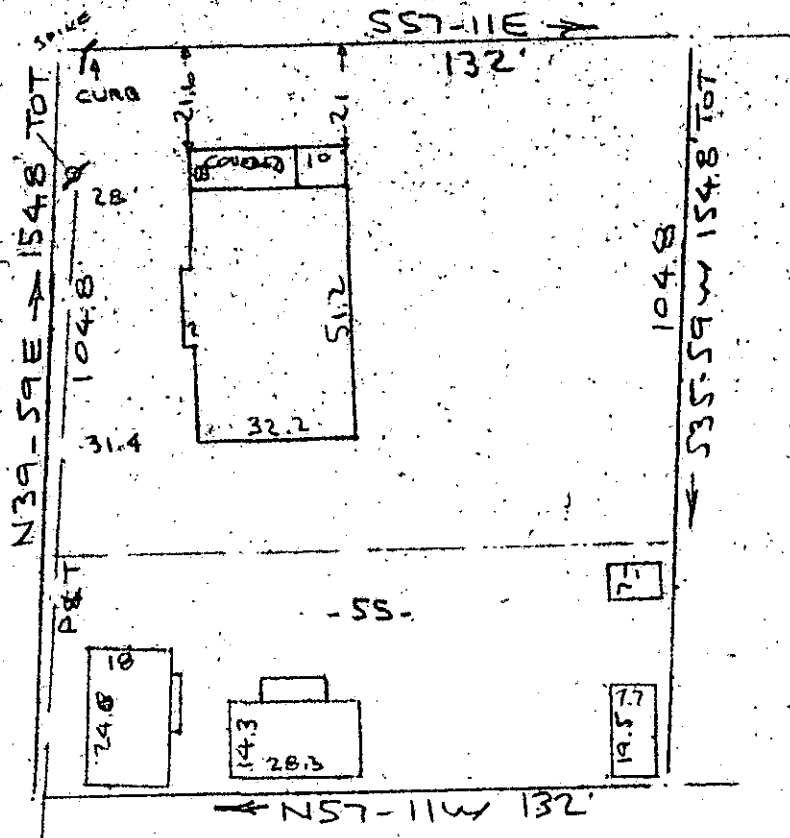

-54-

FILED
GREENVILLE CO. S. C.
MAY 3 4 34 PM '72
OLLIE FARNSWORTH
R.M.C.

10' ALLEY

RECORDING FEE
PAID \$ 1.00

PROPERTY OF
DOT PROPERTIES, INC.
NEAR GREENVILLE, S. C.
SCALE: 1"=40' 2 MAY 1972

This is to certify that on the 2nd day of May 1972, I surveyed the property shown on this plat, being known as lot 55 on plat of DOT PROPERTIES, INC. and recorded in the RMC Office Greenville County, S.C., in Plat Book at Page ; and that the property lines, walls and buildings are as shown hereon, and that the walls and buildings located on said lot do not encroach or project on adjacent street or property, and that no adjacent walls or buildings encroach or project on said premises, and no power lines cross this property except as shown hereon.

R. B. Bruce
R. B. Bruce, RLS #1952

MAY 3 - 1972
29728

40-58 ✓
1.00

CAROLINA SURVEYING COMPANY
112 Manly Street

Greenville, S. C.