


RECORDING FEE PAID \$ 1.00

MICROFILMED

UNRECORDED

Portion Lot 21 N 2-30W 202.16'

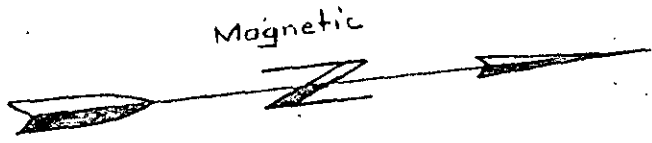


Sulphur Springs Road

Lot 22

Lot 21

Lot 20

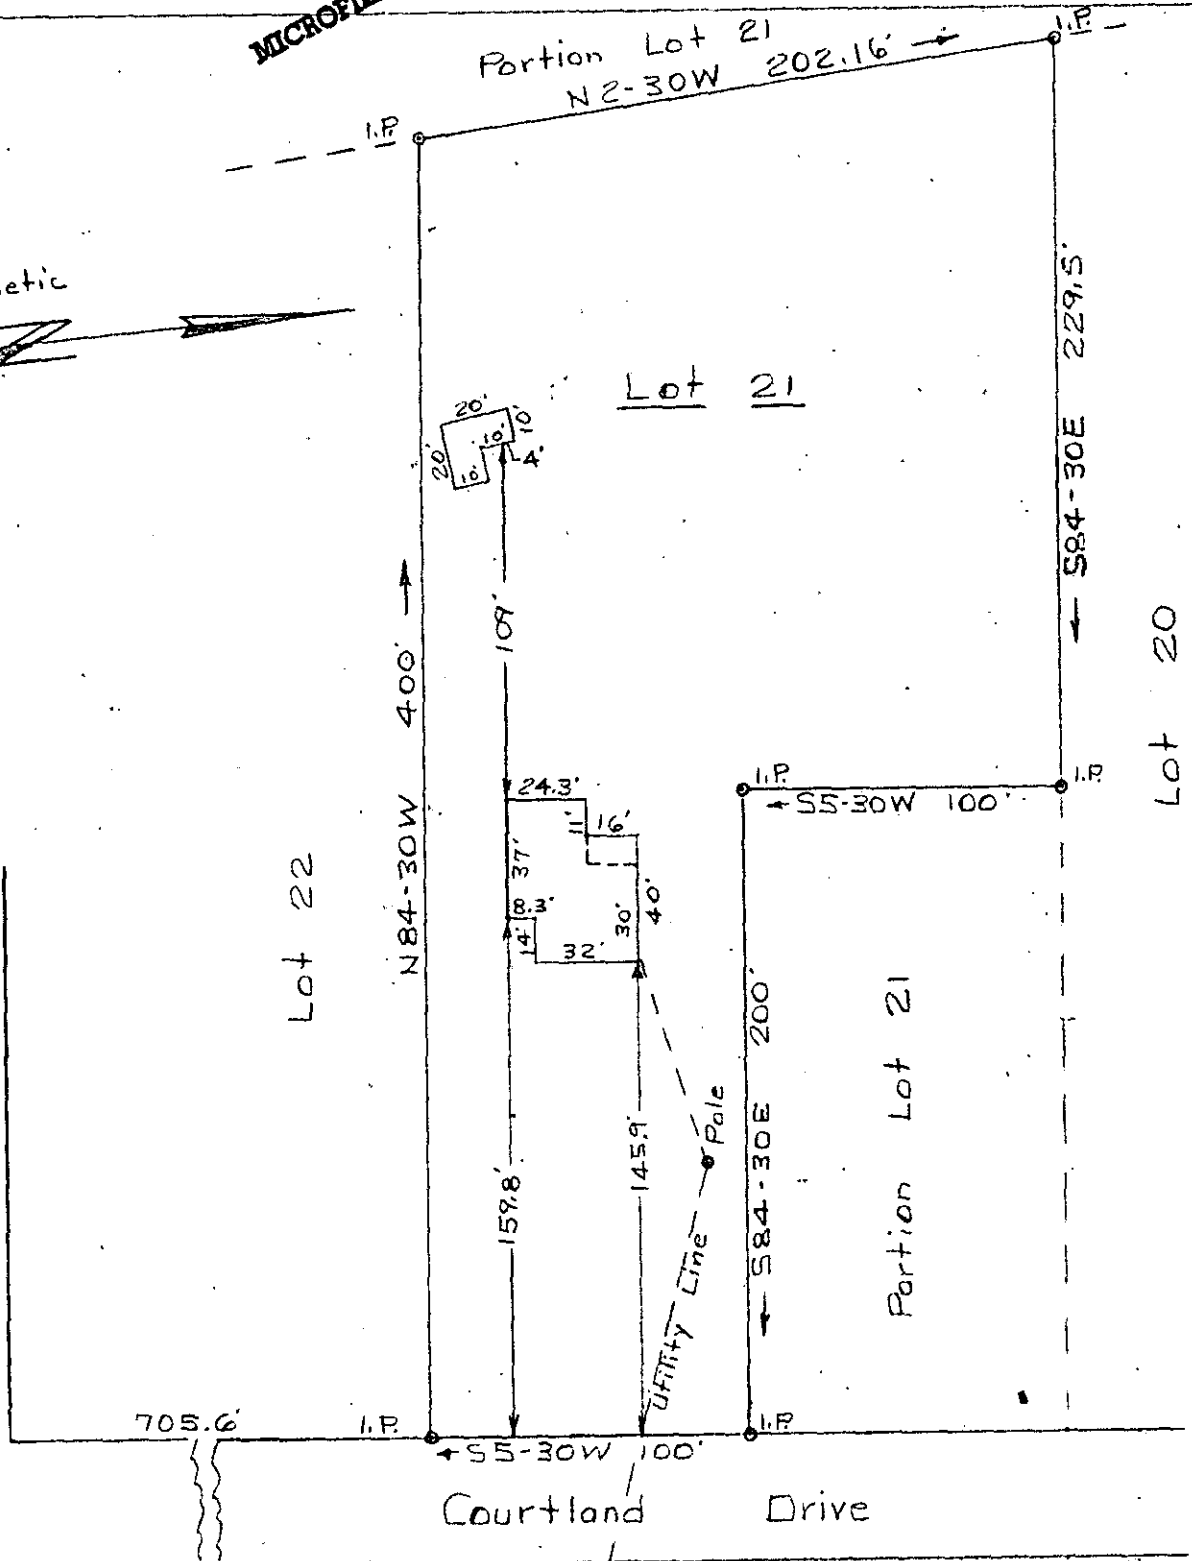

PROPERTY OF MARVIN S. & MARY ANN STONE GREENVILLE, CO. S.

Scale 1"=60' June 24, 1972

JUN 26 1972 FILED GREENVILLE CO. S. 35194 JUN 22 10 00 AM '72 OLLIE FARNSWORTH R.M.C.

This is to certify that on the 24th day of June 1972, I surveyed the property shown on this plat: being the remainder of Lot 21 on plat of "HIGHVIEW ACRES" recorded in Flat Book "9" at page 123 in the R.M.C. Office of Greenville Co. S.C. and that the property line, walls and buildings are as shown hereon, and that the buildings located on said lot do not encroach or project onto adjacent streets or property and that no adjacent buildings or walls encroach or project on to said premises, and that the utility lines are as shown.

T.H. Walker Jr. T.H. WALKER JR. Reg. L.S. 3182 300 Maple Drive Mauldin, S. C. 29662

40 - 138