

10 22 70  
9 17 74

Paul Holladay  
Southland Properties, Inc.  
By: R. Brad Age, Pres

CERTIFICATE OF ACCURACY

PERFORMANCE BOND POSTED  
FOR CORPORATION APPROVAL

Director of Planning  
Greenville County  
Planning Commission

FOR P.E.A.P. Plans, P.P. Hampton 9/11/74  
10-18-70 Robert E. Rembert  
S. C. Registered Professional Engineer

CERTIFICATE OF APPROVAL FOR RECORDING

I hereby certify that the above plat has been examined and found to conform to the requirements of the laws of this State and the rules of the Board of Registrars of Deeds of this County. The office of the County Registrar is at the office of the County Registrar, Greenville, S.C.

OCT. 23 70 J. Coleman Stovall  
County Registrar

REVISED  
SEPT 26 1974  
DATE  
J. Coleman Stovall

FILE NUMBER 70-132

FINAL PLAT

Mountainbrooke  
GREENVILLE COUNTY, S.C.


THE ERWIN COMPANY OWNER  
SOUTHLAND PROPERTIES, INC.

ROBERT E. REMBERT SURVEYOR  
LOTS 10-16 & LOTS 61-65 REVISED 9/11/74  
BY: PIEDMONT ENGINEERS-ARCHITECTS-PLANNERS

NO. OF ACRES 44.0 MILES OF NEW ROADS .98

NO. OF LOTS 84 DATE 10-19-70

SCALE 1" = 100'

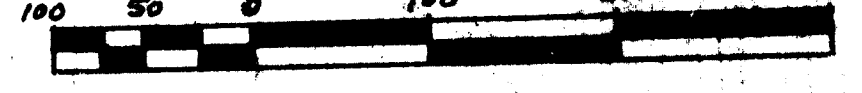

#8186 Filed This 26 day of Sept 1974  
And Recorded in Vol. 4X Page 84 at 12:08 PM  
Ronnie D. Tankersley  
Register Mesne Conveyance Greenville County, S.C.

#8186  
SEP 26 1974  
4X-84

FILED  
GREENVILLE CO. S.C.  
SEP 27 1974  
COUNTY CLERK