


BUNCOMBE RD.

This is to certify that on March 2, 1982, I surveyed the property shown on this plat, known as Property of John T. Douglas, Jr. As Trustee, recorded in the RMC Office of Greenville County in Deed Book 938 on page 365, and that the property lines, walls and buildings are as shown hereon; that the building located on said lot does not encroach or project on adjacent streets or property, and that no adjacent walls or buildings encroach or project on said premises, and that no utility lines cross this property except as shown hereon. This property is not located in a designated flood hazard area.

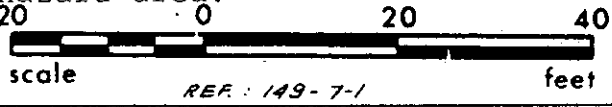

James R. Freeland
James R. Freeland RLS & PE 4781

REF: 149-7-1



**STATE OF SOUTH CAROLINA
GREENVILLE COUNTY**

FREELAND & ASSOCIATES
Engineers • Land Surveyors

GREENVILLE, S.C.

SURVEY FOR

WILLIAM R. GIBBS 23267

9-B-4 ✓

SURVEY L.T.
DRAWN B.R.
CHECK
SCALE 1" = 20'
DATE MARCH 2, 82
DWG. NO. 7269

SEAL

300 8 32261801 PRINT MACHINE INC.