This is to certify that on April 26, 1982, I surveyed the property shown on this plat, known as Lot 86 on plat of Sans Souci Heights, recorded in the RMC Office of Greenville County in Plat Book Y on page 25, and that the property lines, walls and buildings are as shown hereon; that the building located on said lot does not encroach or project on adjacent streets or property, and that no adjacent walls or buildings encroach or project on said premises, and that no utility lines cross this property except as shown hereon. This property is not located in a designated flood hazard area.

300 Tindal Road


3,00

8

34241801

21350 James R. Freeland RLS & PE 4781

(139-14-6) 9-R-22

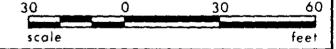

LAND SURVEYOR

VO. 4781

RALPH FREE

RALPH

SEAL

STATE OF SOUTH CAROLINA
GREENVILLE COUNTY

SANS SOUCHHEIGHTS
LOT 86

PROPERTY OF

K. MICHAEL DOCKINS

KATHY SUE DOCKINS

FREELAND & ASSOCIATES

Engineers • Land Surveyors

GREENVILLE, S.C.

SURVEY DW

DRAWN B.R.

CHECK M.C

SCALE M= 30'

DATE APRIL 26.82

DWG. NO. 7405