


This is to certify that on April 26, 1982, I surveyed the property shown on this plat, known as Property of Ward S. Stone Jr., recorded in the RMC Office of Greenville County in Deed Book 1153 on page 642, and that the property lines, walls and buildings are as shown hereon; that the building located on said lot does not encroach or project on adjacent streets or property, and that no adjacent walls or buildings encroach or project on said premises, and that no utility lines cross this property except as This property is not located in a designated flood hazard shown hereon. area.

10 David Street



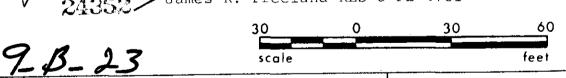

SEAL

STATE OF SOUTH CAROLINA **GREENVILLE COUNTY**

PROPERTY OF SOX STEVE SOX TERRI

FREELAND & ASSOCIATES Engineers • Land Surveyors

GREENVILLE, S.C.

SURVEY D.W.	
DRAWN B.R.	
CHECK MLC	
SCALE /"= 30'	
DATE APRIL 26.82	
DWG. NO. 7404	