


FILED  
 GREENVILLE COUNTY S.C.  
 MAY 4 11 34 AM 1982  
 JAMES R. FREELAND  
 R.M.C.

This is to certify that on April 29, 1982, I surveyed the property shown on this plat, known as Lot 156 on plat of Forrester Woods Sec. 3 recorded in the RMC Office of Greenville County in Plat Book 4R on page 51, and that the property lines, walls and buildings are as shown hereon; that the building located on said lot does not encroach or project on adjacent streets or property, and that no adjacent walls or buildings encroach or project on said premises, and that no utility lines cross this property except as shown hereon. This property is not located in a designated flood hazard area.

*James R. Freeland*  
 James R. Freeland RLS & PE 4781

24561  
 9-B-30  
 MAY 4 1982

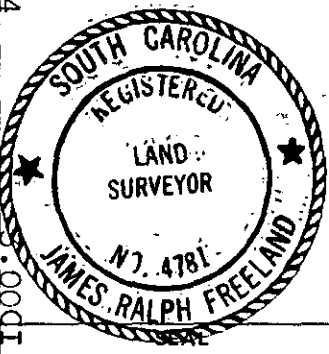

**STATE OF SOUTH CAROLINA  
 GREENVILLE COUNTY**

FORRESTER WOODS  
SECTION 3 - LOT 156  
 PROPERTY OF  
GRAYSON A GOODMAN  
JANET L. GOODMAN

FREELAND & ASSOCIATES  
 Engineers • Land Surveyors

GREENVILLE, S.C.

SURVEY DG  
 DRAWN JRF  
 CHECK \_\_\_\_\_  
 SCALE 1" = 40'  
 DATE 4-29-82  
 DWG. NO. 82-7425