


This is to certify that on April 28, 1982, I surveyed the property shown on this plat, known as Lot 91 on plat of Abney Mills Sec. 1, recorded in the RMC Office of Greenville County in Plat Book QQ on pages 56 & 57, and that the property lines, walls and buildings are as shown hereon; that the building located on said lot does not encroach or project on adjacent streets or property, and that no adjacent walls or buildings encroach or oproject on said premises, and that no utility lines cross this property except as shown hereon. This property is not located in a designated flood hazard area.

24689

9-B-32



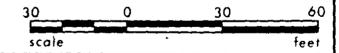

STATE OF SOUTH CAROLINA GREENVILLE COUNTY

MILLS ABNEY SEC. 1 ; LOT 91 PROPERTY OF

DAVIO E ANDREWS

FREELAND & ASSOCIATES Engineers • Land Surveyors

GREENVILLE, S.C.

	_
SURVEY O.W.	
DRAWN B.R.	_
CHECK MAT	
SCALE /"= 30'	
DATE APRIL 28.82	
DWG. NO. 74/7	_

PRINT MACHINE INC.