


This is to certify that on May 20, 1982, I surveyed the property shown on this plat, known as Lot 82 & Pt. 83 on plat of Powderhorn Sec. 2, recorded in the RMC Office of Greenville County in Plat Book 6H on page 49, and that the property lines, walls and buildings are as shown hereon; that the building located on said lot does not encroach or project on adjacent streets or property, and that no adjacent walls or buildings encroach or project on said premises, and that no utility lines cross this property except as a shown hereon. This property is not located in a designated flood hazard area.

5' drainage and utility easement each side of all side and rear lot lines.

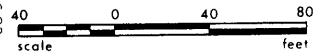

James R. Freeland RLS & PE 4

9-13-63

323-1-83

STATE OF SOUTH CAROLINA GREENVILLE COUNTY



POWDERHORN

SEC. Z - LOT 82 & PT. LOT 83

PROPERTY OF

ERNEST R. SILER &

FREELAND & ASSOCIATES Engineers • Land Surveyors

GREENVILLE, S.C.

SURVEY		
DRAWN	SRC	
CHECK	MLC	
SCALE	1"= 40"	
DATE	5-20-82	
DWG. NO.	7481	