


FILED
GREENVILLE CO. S. C.
JUN 11 3 59 PM '82
DONNIE S. TANKERSLEY
R.M.C.

F.A. DAVIS JR. N/F

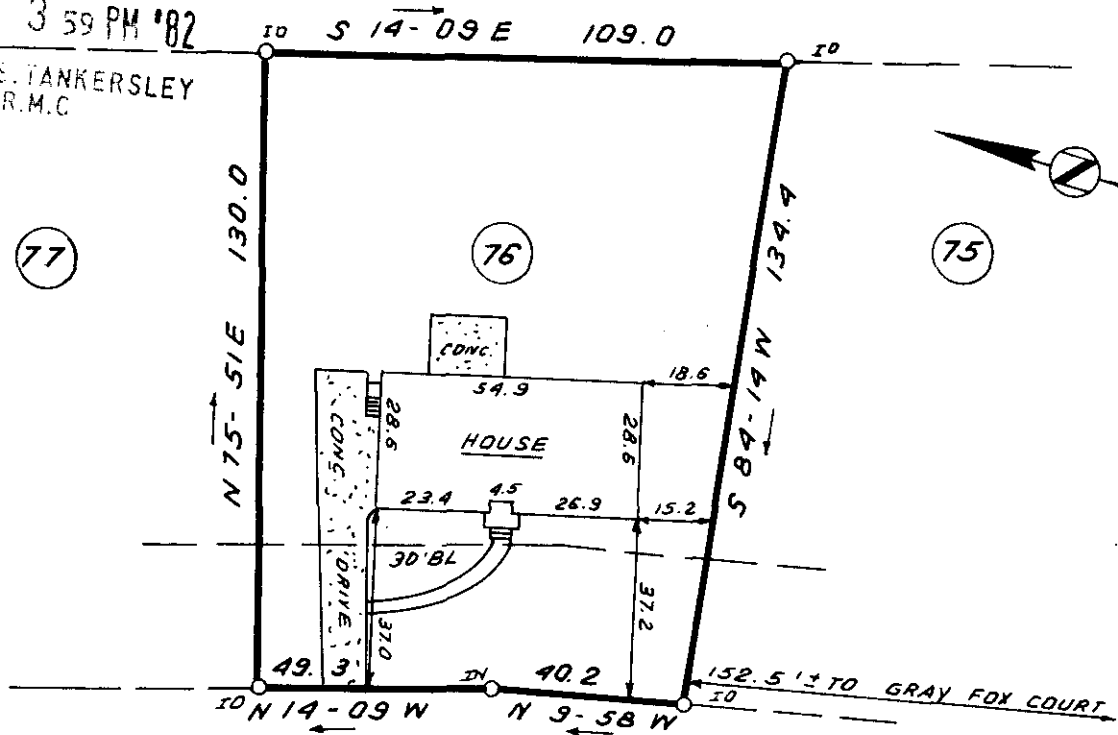

GRAY FOX SQUARE

This is to certify that on June 8, 1982, I surveyed the property shown on this plat, known as Lot 76 on plat of Gray Fox Run Sec. 1, recorded in the RMC Office of Greenville County in Plat Book 5P on page 16, and that the property lines, walls and buildings are as shown hereon; that the building located on said lot does not encroach or project on adjacent streets or property, and that no adjacent walls or buildings encroach or project on said premises, and that no utility lines cross this property except as shown hereon. This property is not located in a designated flood hazard area.

5' drainage and utility easement each side of all side and rear lot lines.

James R. Freeland
James R. Freeland RLS & PE 4781

9-B-99 ✓ 27857



538.14 - 1 - 76

JUN 11 1982



**STATE OF SOUTH CAROLINA
GREENVILLE COUNTY**

FREELAND & ASSOCIATES
Engineers • Land Surveyors

GREENVILLE, S.C.

GRAY FOX RUN
SEC. 1 ; LOT 76
PROPERTY OF
DARRELL L. FETZER |
LEOLA C. FETZER |

SURVEY D.C.H.
DRAWN B.R.
CHECK *M.L.S.*
SCALE 1" = 40'
DATE JUNE 8, 1982
DWG. NO. 7536

DATA 2 JUN 11 1982 149 3.00CI