

K.C. 3-8204-A

9.C

Toll Line _____
(Name)

Or Exchange Line Greenville, S.C.
(Exchange)

The Property is bounded where the line enters and leaves this property by the property of:

W.H. Burns on the N. and _____ on the _____


Number of poles covered by this permit _____

Number of Guys and Anchors _____

The poles have the following numbers: _____

from No. _____ to No. _____

Poles are located on private property and in Streets and Highways as shown on the following diagram.

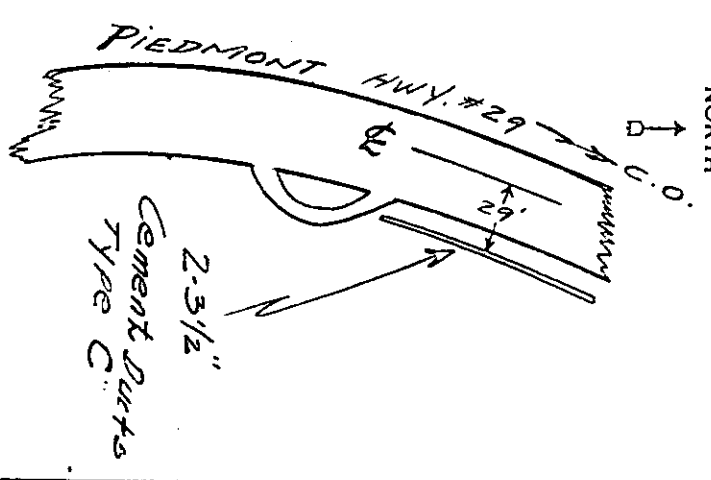

DEC 11 1955
GENERAL PERMIT

Form 6196-A
(Sept., '40)

\$ 1.00 Received of the SOUTHERN BELL TELEPHONE AND TELEGRAPH COMPANY, (INCORPORATED)

One and No. 100 Dollars in consideration of which I hereby grant unto said Company, its associated and allied companies, their respective successors and assigns, the right, privilege and authority to construct, operate and maintain its lines of Telephone and Telegraph, and for the general transmission of intelligence, consisting of such poles, wires, cables, conduits, guys, anchors and other fixtures and appurtenances as the grantee may from time to time require, upon, across, over and/or under the property which I own or in which I have any interest in the County of Greenville and State of S.C. and upon, along and/or under the roads, streets, or highways adjoining the said property, and the right to permit the attachment of and/or carry in conduit wires and cables of any other company or person, and with the further right to trim and cut down and to keep trimmed and cut down all trees and undergrowth within _____ feet of said line, and in addition thereto, the grantee shall have the right to cut down, from time to time, all dead, weak, leaning or dangerous trees that are tall enough to reach the wires in falling; said sum being received in full payment for the rights herein granted.

Witness my hand and seal this 9 day of Dec., 1955, at Greenville RT. 51 (Post Office Address)
Witness J. W. Landgraf, Jr. R. D. Cochran (L. S.)
R. D. Plemons (L. S.)
(Land Owner)
R. D. Cochran

STATE OF SOUTH CAROLINA,
COUNTY OF GREENVILLE

Personally appeared before me J. W. Landgraf, Jr.
made oath that he saw the within named R. D. Cochran
sign, seal and as his her their act - I read, deliver the within instrument, and
that he with R. D. Plemons witnessed the execution
thereof.

Sworn to before me, this 16th
day of Dec A.D. 1955
J. W. Landgraf, Jr.
Notary Public, S. C.

Recorded December 16th, 1955 at 1:56 P.M. #32456