

K.C. 3-8204-A
9C
Maudgraf, Jr.

Toll Line _____
(Name)

Or Exchange Line Greenville S.C.
tributary to _____
(Exchange)

The Property is bounded where the line enters and leaves this property by the property of:

W.A. Burns on the S. and _____ on the _____

_____ on the _____


Number of poles covered by this permit _____

Number of Guys and Anchors _____

The poles have the following numbers:

from No. _____ to No. _____

Poles are located on private property and in Streets and Highways as shown on the following diagram.

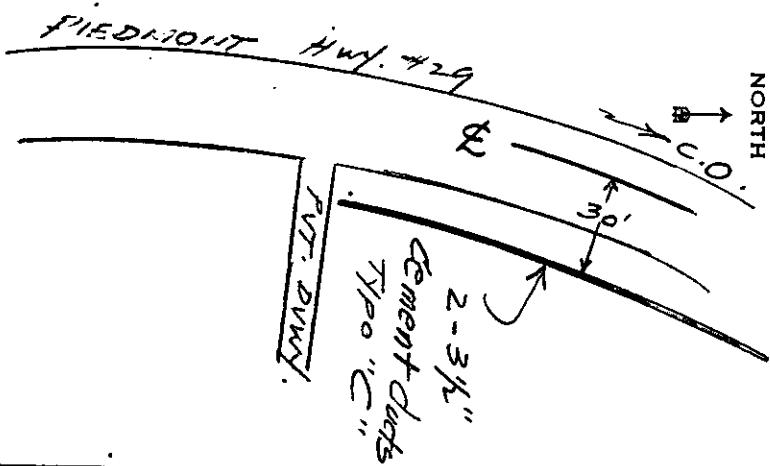

DEC 16 1955

Form 6196-A
(Sept. '40)

GENERAL PERMIT

\$ 1.00 Received of the SOUTHERN BELL TELEPHONE AND TELEGRAPH COMPANY, (INCORPORATED)

One and NO /100 Dollars in consideration of which I hereby grant unto said Company, its associated and allied companies, their respective successors and assigns, the right, privilege and authority to construct, operate and maintain its lines of Telephone and Telegraph, and for the general transmission of intelligence, consisting of such poles, wires, cables, conduits, guys, anchors and other fixtures and appurtenances as the grantee may from time to time require, upon, across, over and/or under the property which I own or in which I have any interest in the County of Greenville and State of S.C. and upon, along and/or under the roads, streets, or highways adjoining the said property, and the right to permit the attachment of and/or carry in conduit wires and cables of any other company or person, and with the further right to trim and cut down and to keep trimmed and cut down all trees and undergrowth within 10 feet of said line, and in addition thereto, the grantee shall have the right to cut down, from time to time, all dead, weak, leaning, or dangerous trees that are tall enough to reach the wires in falling; said sum being received in full payment for the rights herein granted.

Witness my hand and seal this 9 day of December 19 55, at Greenville, S.C. RT. 8
(Post Office Address)

Witness Maudgraf, Jr. W.L. Brown (L.S.)
R.D. Plemon (L.S.)
(Land Owner)

Mrs. W. L. Brown

STATE OF SOUTH CAROLINA,
COUNTY OF GREENVILLE

Personally appeared before me J. N. [Signature] who made oath that he saw the Mrs. W. L. Brown sign, seal and as his her R.D. Plemon that he with R.D. Plemon thereof.

Sworn to before me, this 16th day of Dec A.D. 1955

Clie [Signature]
Notary Public, S. C.

Recorded December 16th, 1955 at 1:56 P.M. #32456