 

Recorded April 20th, 1956 at 2:34 P.M. #10204

APR 30 1956

10204