


554 108 X

E-297-A 303

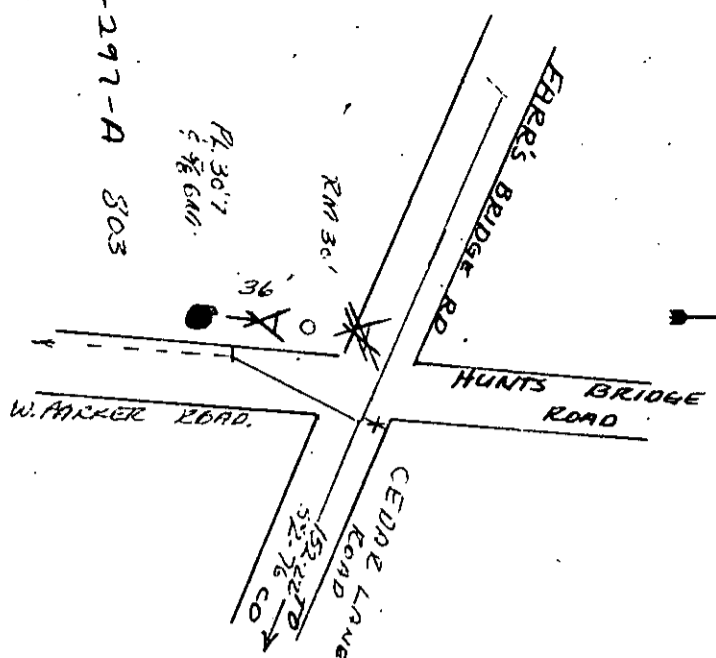

Name and Post Office Address of Grantor J. H. Philpot
Berea Crossroads
Greenville, S.C.

Roll Line _____ (Name)
 Or Exchange Line Greenville (Exchange)
 tributary to _____

The Property is bounded, where the line enters and leaves this property by the property of:
Harry Chapman on the W and
Wood Road on the S

The poles (or stakes) have the following identification: _____ to _____

Authority 63-1541 Classification 9C

Area _____

Approved J. H. Philpot

Title Superior

NORTH

GEP 47.101

GENERAL PERMIT

(INDIVIDUAL) Form 8416 Nov. '54

Received of the SOUTHERN BELL TELEPHONE AND TELEGRAPH COMPANY One and no /100 Dollars in consideration of which (I) (We) hereby grant said Company, its associated and allied companies, their respective licensees, successors and assigns, the right to construct, operate and maintain a line of communication consisting of such poles, wires, cables, conduits, guys, anchors and other necessary appurtenances as from time to time are required upon, across, over and/or under that certain tract of land situated in Greenville County, State of South Carolina, to-wit:

This property is on W. Parker Road at the intersection of
Hunts Bridge Road and Farris Bridge Road in Berea

and upon, along and under the roads, streets, or highways adjoining or through said property with the right to permit the attachment of and/or carry in conduit wires and cables of any other person or company for communications purposes or for the transmission and distribution of electric power and the right of ingress and egress to said premises at all times for the purpose of inspecting and maintaining said line and with the right to clear and keep cleared all trees, undergrowth or other obstructions within a strip of land 10 feet on each side of the center of said line and to trim and cut and keep trimmed and cut all dead, weak, leaning or dangerous trees which might reach said line in falling; including the right to relocate said line on said premises to conform to any future highway relocation, widening or improvement; the said sum being received in full payment for the rights herein granted.

Signed, sealed and delivered in the presence of:

S. A. Philpot
W. B. Clinton, Jr.

Executed May 21, 1956

J. H. Philpot (SEAL)
I. H. PHILPOT (SEAL)

GEP 47.101

ACKNOWLEDGMENTS

For Use in South Carolina

Form 8425 Nov. '54

Individual Form

STATE OF SOUTH CAROLINA }
 COUNTY OF _____ } ss.

Personally appeared before me W. B. Clinton, Jr.
 and made oath that (he) (she), with S. A. Philpot saw the within named
I. H. Philpot

sign, seal, and deliver as (his) (her) (their) act and deed the within written instrument, and that (he) (she) with the said S. A. Philpot witnessed the execution thereof.

Sworn to before me this 29 day of May, A.D. 1956 W. B. Clinton, Jr.

I. H. Philpot, Jr.
 Notary Public

Recorded June 4, 1956 at 9:14 A.M. # 14254