


E-29774 116-0 & 116-N

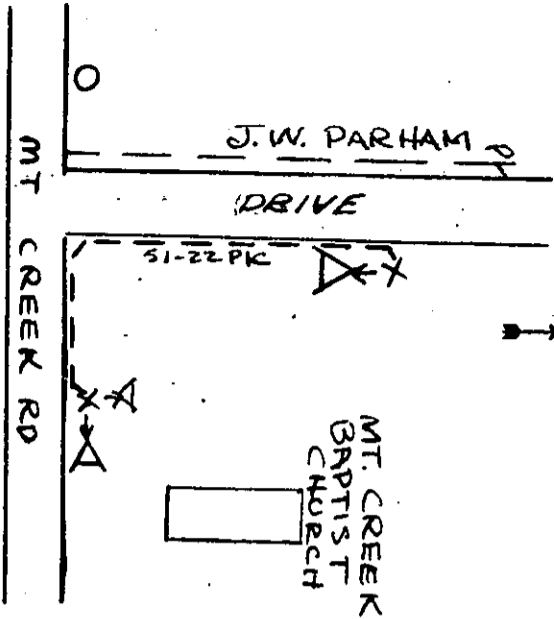

Name and Post Office Address of Grantor MT CREEK BAPTIST CHURCH
RT # 2 TAYLORS, SC

Toll Line _____ (Name)
 Exchange Line GREENVILLE (Exchange)
 tributary to _____

The Property is bounded where the line enters and leaves this property by the property of:
S.W. PARHAM on the W and MT CREEK RD. on the S

The poles (or stakes) have the following identification: BURIED & ABLE to Fern Ave Co. Authority 63-1848E Classification 9C

Area GREENVILLE

Approved: [Signature]

Title [Signature]

GEP 47.101

GENERAL PERMIT

(INDIVIDUAL)

Form 8416 Nov. '54

Received of the SOUTHERN BELL TELEPHONE AND TELEGRAPH COMPANY ONE AND /100 Dollars in consideration of which (We) hereby grant said Company, its associated and allied companies, their respective licensees, successors and assigns, the right to construct, operate and maintain a line of communication consisting of such poles, wires, cables, conduits, guys, anchors and other necessary appurtenances as from time to time are required upon, across, over and/or under that certain tract of land situated in GREENVILLE County, State of SC, to-wit:

LOCATED ON MT. CREEK ROAD ADJACENT TO MT. CREEK BAPTIST CHURCH BUILDING

and upon, along and under the roads, streets, or highways adjoining or through said property with the right to permit the attachment of and/or carry in conduit wires and cables of any other person or company for communications purposes or for the transmission and distribution of electric power and the right of ingress and egress to said premises at all times for the purpose of inspecting and maintaining said line and with the right to clear and keep cleared all trees, undergrowth or other obstructions within a strip of land NONE feet on each side of the center of said line and to trim and cut and keep trimmed and cut all dead, weak, leaning or dangerous trees which might reach said line in falling; including the right to relocate said line on said premises to conform to any future highway relocation, widening or improvement; the said sum being received in full payment for the rights herein granted.

Signed, sealed and delivered in the presence of:

Wilton C. Fleming
W.E. Young
J. E. Hall

930 Executed 12-5, 19 56

B.A. Griswold, Chm Deacons (SEAL)
J.A. Cave, Pastor (SEAL)
 B.A. GRISWOLD, CHM. BOARD OF DEACONS
 J.A. CAVE (PASTOR) (JEH)

GEP 47.101

ACKNOWLEDGMENTS
 For Use in South Carolina

Form 8425 Nov. '54

Individual Form

STATE OF SOUTH CAROLINA }
 COUNTY OF GREENVILLE } ss.

Personally appeared before me J.E. HALL
 and made oath that (he) (~~she~~) with WILTON C. FLEMING & W.E. YOUNG saw the within named BA. GRISWOLD (CHAIRMAN BOARD OF DEACONS) AND J.A. CAVE (PASTOR) sign, seal, and deliver as (~~his~~) (~~her~~) (their) act and deed the within written instrument, and that (he) (~~she~~) with the said W.C. FLEMING & W.E. YOUNG witnessed the execution thereof.

Sworn to before me this 11th day of Jan A.D. 1957
[Signature]
 Notary Public

Recorded January 11th, 1957, at 2:41 P. M.
 #930