


E 2979 SMT, 704-596-B

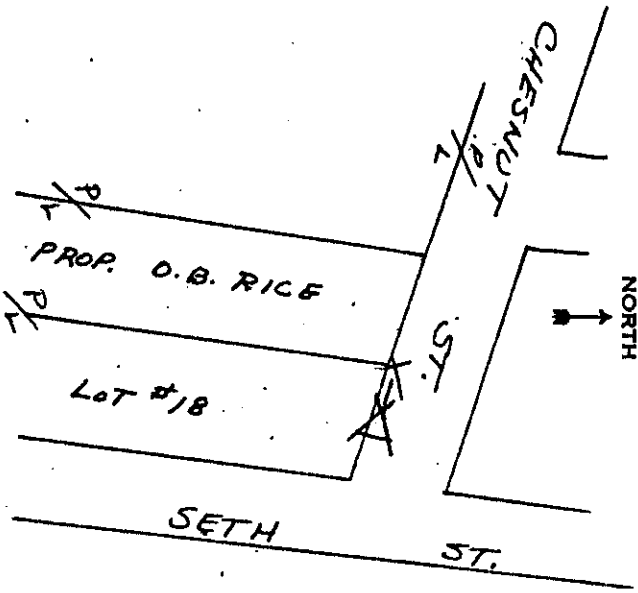

Name and Post Office Address of Grantor: JAMES LAKE EUBANKS
ROUTE 8 STATION BRDG. RD.
GREENVILLE, SO. CAR.

Toll Line _____ (Name)
 Or, Exchange Line _____ (Name)
 Tributary to _____ (Exchange)

The Property is bounded where the line enters and leaves this property by the property of:
O. B. RICE on the W and
SETH STREET on the E

The poles (or stakes) have the following identification: ANCHOR to _____

Authority: 23-1255 Classification: 9-C
 Area: GREENVILLE, S.C.
 Approved: _____
 Title: SUBV. ENG.

GEP 47.101

CLEARANCE PERMIT 14274-4 (INDIVIDUAL)

Form 8422 Nov. '54

Received of the SOUTHERN BELL TELEPHONE AND TELEGRAPH COMPANY ONE AND No/100 Dollars in consideration of which (I) ~~(we)~~ hereby grant said Company, its associated and allied companies, their respective successors and assigns, the right to clear and keep cleared trees and undergrowth within at least TWO feet on both sides of the center line of said Company's line on or adjacent to my property in the City of GREENVILLE, County of GREENVILLE, State of SOUTH CAROLINA, and the further right to set and maintain on said property ONE (1) anchors, and attach thereto the necessary guy wires, said sum being received in full payment therefor.

ON A CERTAIN TRACT OF LAND ALONG CHESNUT STREET BOUNDED ON THE EAST BY SETH STREET ON THE WEST BY O. B. RICE AND BOUNDED ON THE NORTH BY CHESNUT STREET.

Executed May 3, 1957

Witness:

Ellen Eubanks
J. H. Ferguson
 ELLEN EUBANKS (RLB)
 J. H. FERGUSON (RLB)

James L. Eubanks (L.S.)
 _____ (L.S.)
 _____ (L.S.)
 _____ (L.S.)
JAMES LAKE EUBANKS (RLB)

GEP 47.101

Form 8426 Nov. '54

ACKNOWLEDGMENTS

For Use in South Carolina

Individual Form

STATE OF SOUTH CAROLINA }
 COUNTY OF GREENVILLE } ss.

Personally appeared before me J. H. FERGUSON
 and made oath that (he) ~~(she)~~, with ELLEN EUBANKS saw the within named
JAMES L. EUBANKS sign,
 seal, and deliver as, (his) ~~(her)~~ ~~(their)~~ act and deed the within written instrument, and that (he) ~~(she)~~ with the
 said ELLEN EUBANKS witnessed the execution thereof.

Sworn to before me this

J. H. Ferguson

7 day of June A.D. 1957

J. H. Ferguson
 Notary Public

Recorded June 14th, 1957 at 1:03 P.M. #14274