STATE OF Oregon)
COUNTY OF Lincoln)

Agnes Emerson:


SWORN to before me this 22/day of May, 1966.

Mon

Notary Public for My Commission Expires 3/24/6

agus E-inonon

ULICO OREC

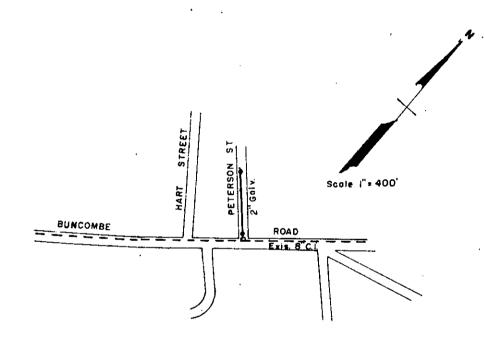

MATERIAL LIST

342' of 2" Galv. Pipe

2 - 2" Valves

Live of a tight

Mrs. Celestine Bailey Et. Al.

T0-

CITY OF GREENVILLE

3-8-66 No. 12

Deed and Extra Probate and Plat Recorded August 11th, 1966 at 2:12 P.M. #4268

RAINEY, FANT & HORTON, ATTYS.