
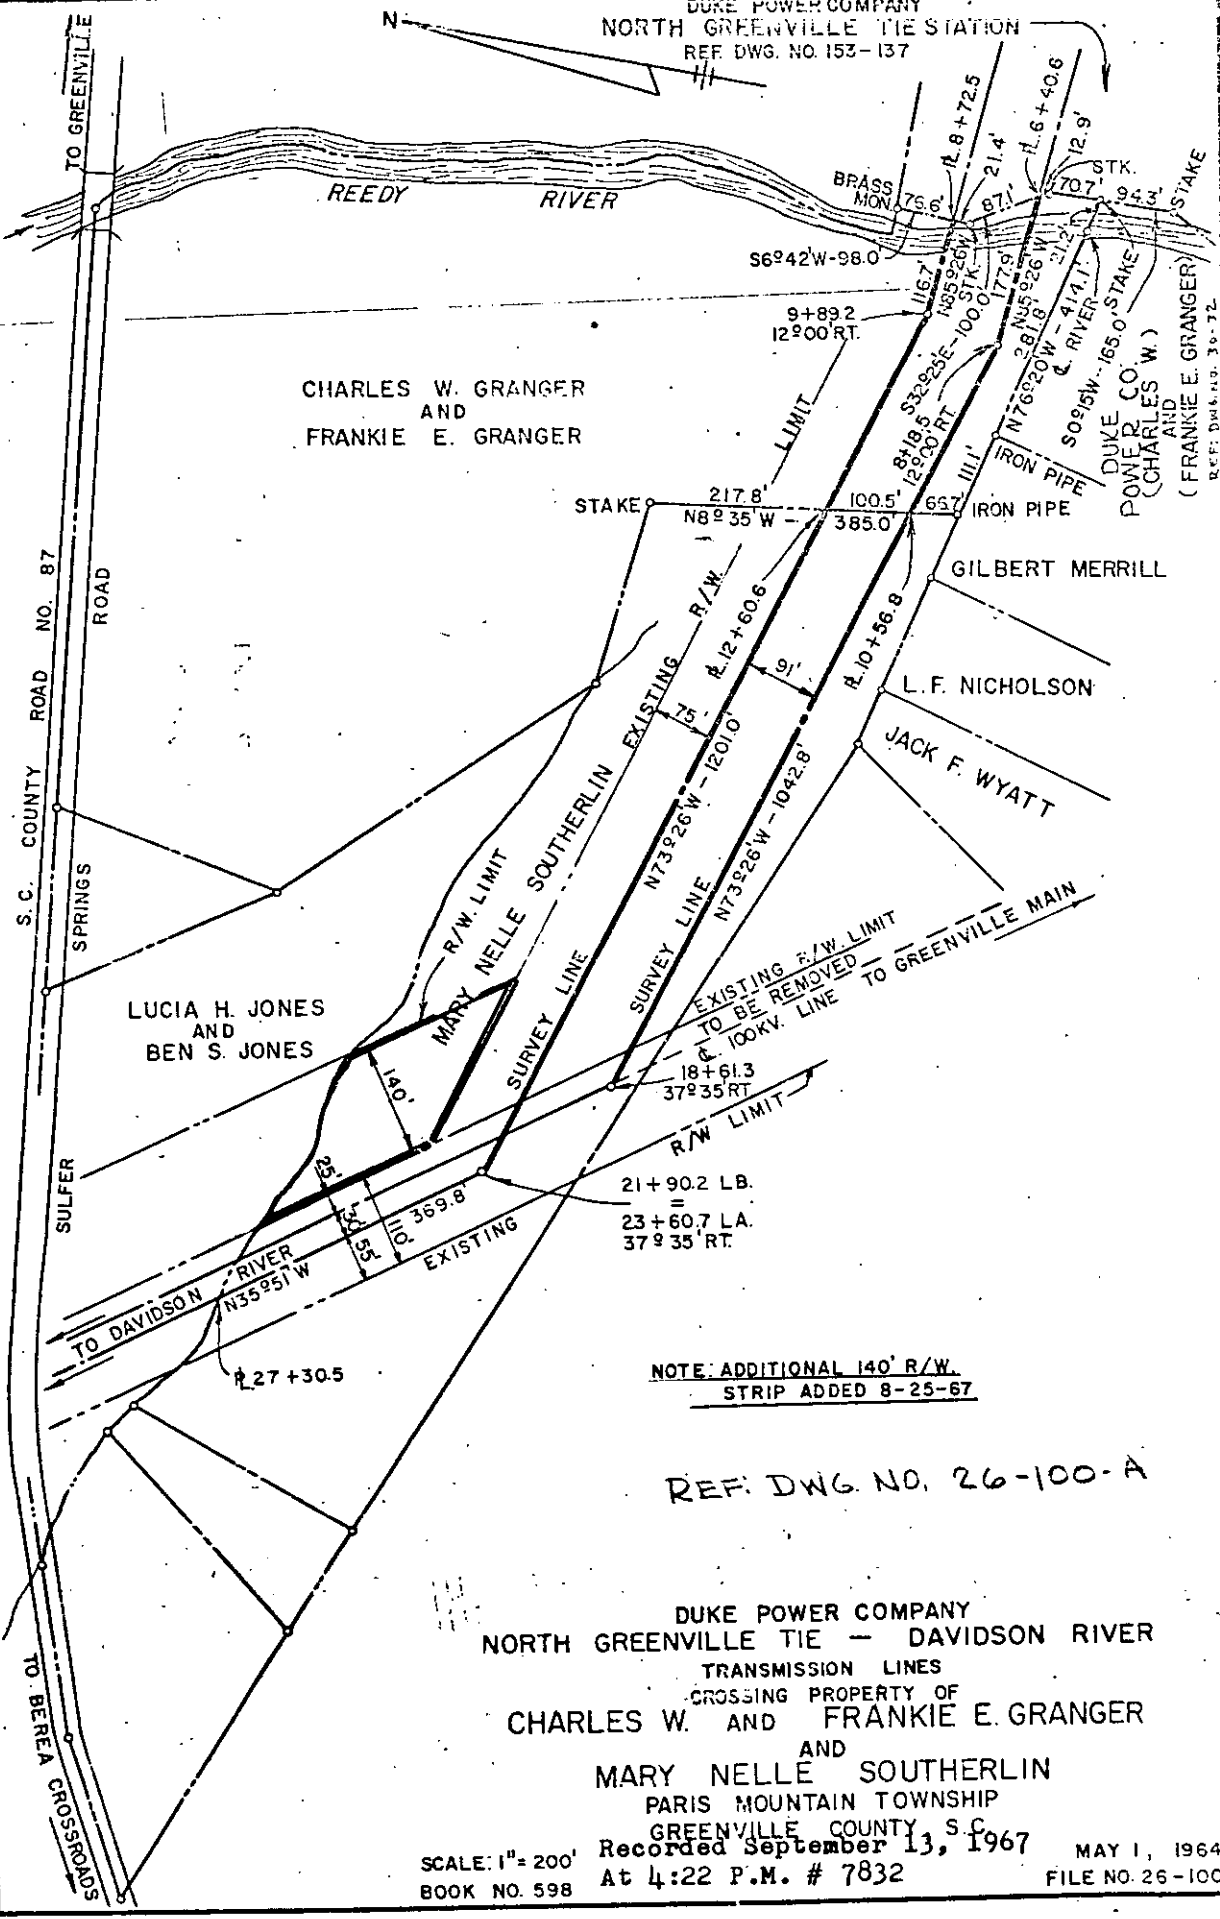


DUKE POWER COMPANY
NORTH GREENVILLE TIE STATION
REF DWG. NO. 153-137

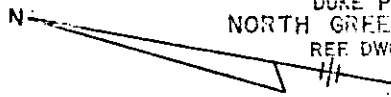

CHARLES W. GRANGER
AND
FRANKIE E. GRANGER

LUCIA H. JONES
AND
BEN S. JONES

MARY NELLE SOUTHERLIN

GILBERT MERRILL

L.F. NICHOLSON

JACK F. WYATT

NOTE: ADDITIONAL 140' R/W
STRIP ADDED 8-25-67

REF: DWG. NO. 26-100-A

DUKE POWER COMPANY
NORTH GREENVILLE TIE - DAVIDSON RIVER
TRANSMISSION LINES
CROSSING PROPERTY OF
CHARLES W. AND FRANKIE E. GRANGER

AND
MARY NELLE SOUTHERLIN
PARIS MOUNTAIN TOWNSHIP
GREENVILLE COUNTY, S.C.

SCALE: 1" = 200'
BOOK NO. 598

Recorded September 13, 1967
At 4:22 P.M. # 7832

MAY 1, 1964
FILE NO. 26-100