


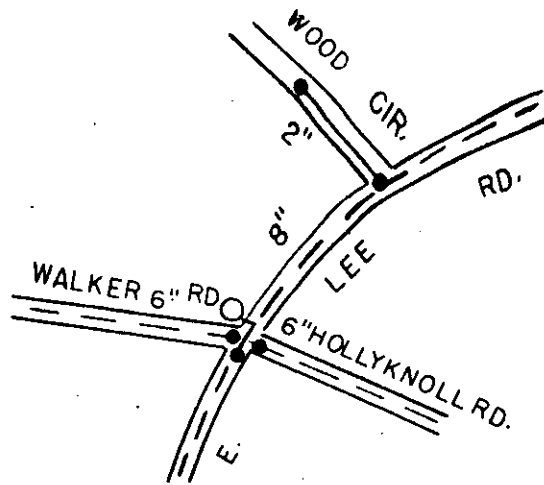

SCALE: 1" = 400'



MATERIAL LIST

- 285' ± - 2" Galv. Pipe
- 2 - 2" Valves

Leonard R. Wood
TO
City Of Greenville, S. C.

October 1967

Recorded November 13, 1967 At 11:53 A.M. # 13954