


CLEVELAND

TRUE MERIDIAN BY OBSERVATION IS S. 36.20'E MARIETTA

GEER HIGHWAY U.S. NO. 276

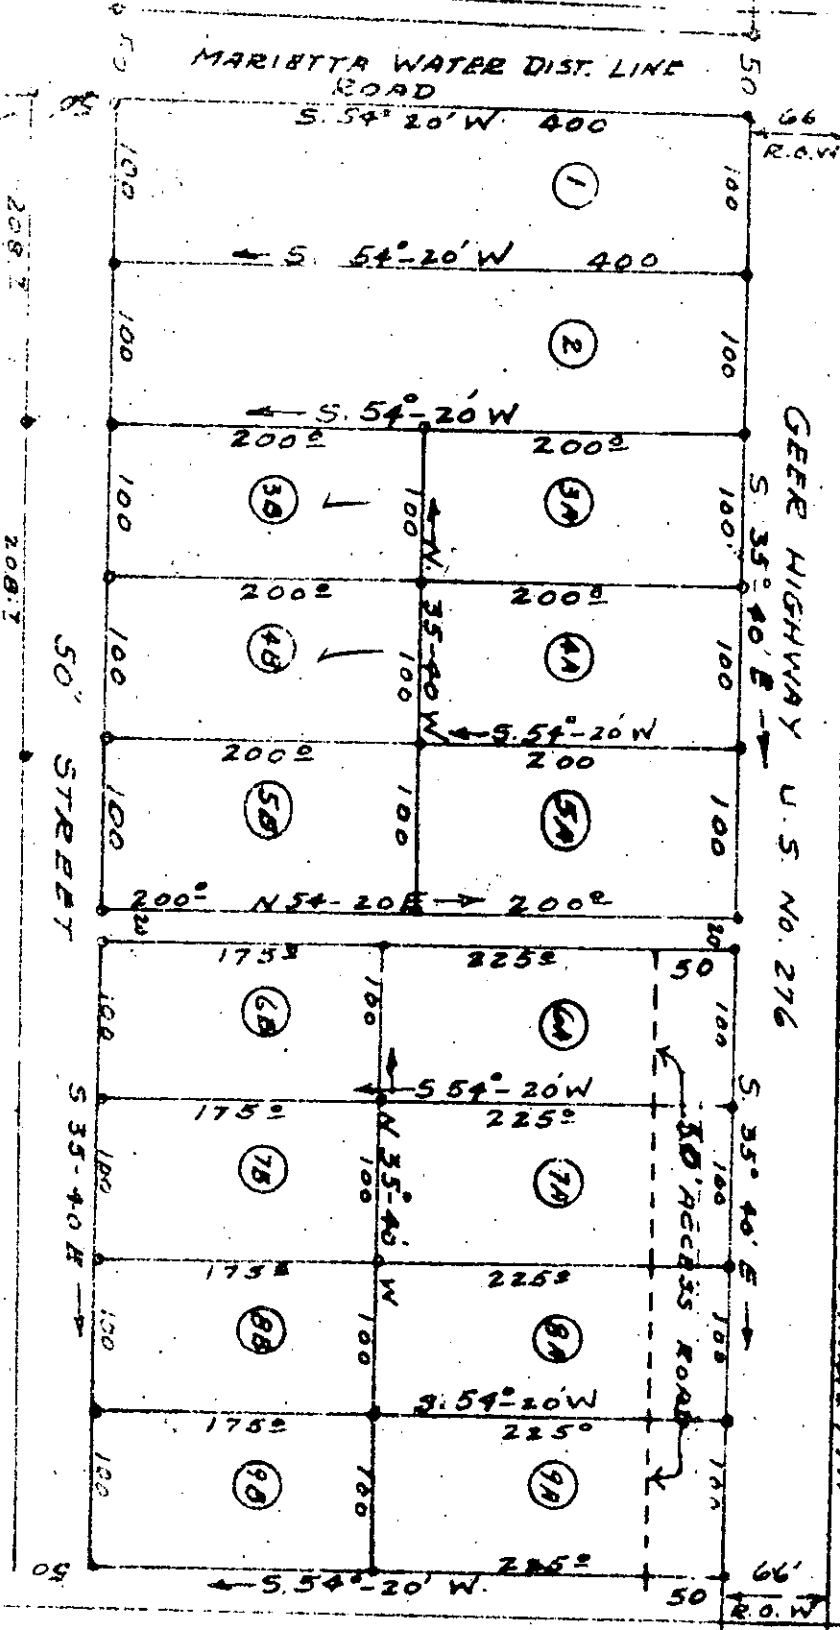

REVISED PART OF

MIDWAY ACRES

NEAR MARIETTA S.C.

CLEVELAND TWP GREENVILLE CO

SOUTH CAROLINA

SUEVER

MAY 1952

1952

Recorded January 19, 1968 At 4:40 P.M. # 19471