


3
\$3.00

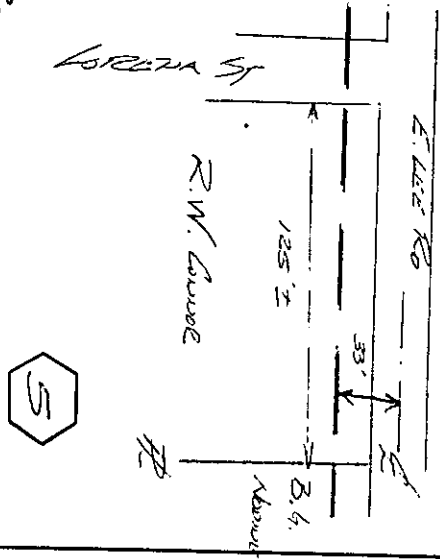

Name and Post Office Address **XX**
 of Grantor Rte 4 Taylors SC.
SC.
 Toll Line _____ (Name)
 Or Exchange Line Greenville S.C. (Exchange)
 tributary to _____
 The Property is bounded where the line enters and leaves this property by the property of:
FOREMAN ST on the W and W on the E and E
 The poles (or stakes) have the following identification: _____ to _____
 Authority S-3382 Classification SS-C
 Area Greenville Dist
 Approved J. H. Ferguson
 Title Robert W. Conner
 NORTH

GEP 47.101 **GENERAL PERMIT** (INDIVIDUAL) Form 8416 Nov. '54

Received of the SOUTHERN BELL TELEPHONE AND TELEGRAPH COMPANY ONE AND --- No. 100 Dollars in consideration of which (I) (We) hereby grant said Company, its associated and allied companies, their respective licensees, successors and assigns, the right to construct, operate and maintain a line of communication consisting of such poles, wires, cables, conduits, guys, anchors and other necessary appurtenances as from time to time are required upon, across, over and/or under that certain tract of land situated in Greenville County, State of South Carolina, to-wit:
THAT TRACT OF LAND BOUND ON THE NORTH BY E. LEE ROAD, WEST FOREMAN ST AND EAST BY B6 HIGHWAY

and upon, along and under the roads, streets, or highways adjoining or through said property with the right to permit the attachment of and/or carry in conduit wires and cables of any other person or company for communications purposes or for the transmission and distribution of electric power and the right of ingress and egress to said premises at all times for the purpose of inspecting and maintaining said line and with the right to clear and keep cleared all trees, undergrowth or other obstructions within a strip of land 170 feet on each side of the center of said line and to trim and cut and keep trimmed and cut all dead, weak, leaning or dangerous trees which might reach said line in falling; including the right to relocate said line on said premises to conform to any future highway relocation, widening or improvement; the said sum being received in full payment for the rights herein granted.

Signed, sealed and delivered in the presence of:
Mrs R. W. Conner
J. H. Ferguson
 Executed MARCH 16th, 1968
Robert Wm. Conner (SEAL)
 (SEAL)

GEP 47.101 **ACKNOWLEDGMENTS** For Use in South Carolina Individual Form Form 8415 Nov. '54

STATE OF SOUTH CAROLINA }
 COUNTY OF Greenville } ss.
 Personally appeared before me JOHN H. FERGUSON
 and made oath that (he) (she), with Mrs R. W. Conner saw the within named
ROBERT W. CONNER

seal, and deliver as (his) (her) (their) act and deed the within written instrument, and that (he) (she) with the said Mrs R. W. Conner witnessed the execution thereof.

Sworn to before me this 28th day of April A.D. 1968.
J. H. Ferguson
 Notary Public
 Recorded April 1, 1968 At 3:37 P.M.
 # 25544