
CAT WILL

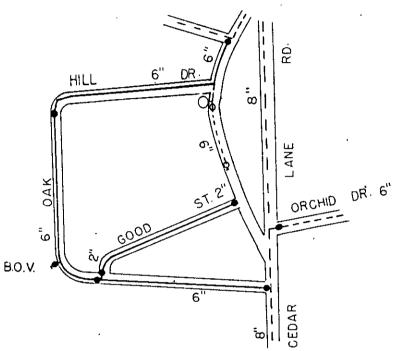

## MATERIAL LIST

2,961'± - 6" Pipe .830' - 2" Pipe 4 - 6" Valves 3 - 2" Valves

Recorded May 31, 1968 At 5:01 P.M. # 31123

Maggie Kuykendall : &
Hugh B. Cureton
TO,
BEREA PUBLIC SERVICE DISTRICT
Scale I" = 400' November 1967