


4

HODGENS DR.

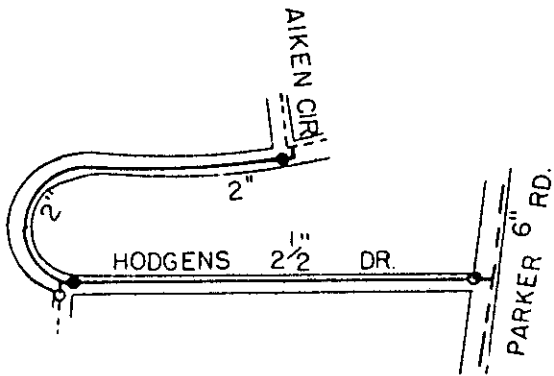

MATERIAL LIST

- 1,000'± - 2" Pipe
- 1,030'± - 2" Pipe
- 2 - 2" Valves
- 1 - 2' Valve

Lela J. Hodgens
 T.D.
 Berea Public Service District
 Scale 1" = 400' November 1967

Recorded May 31, 1968 At 5:01 P.M. # 31122