


COLLEGE PARK

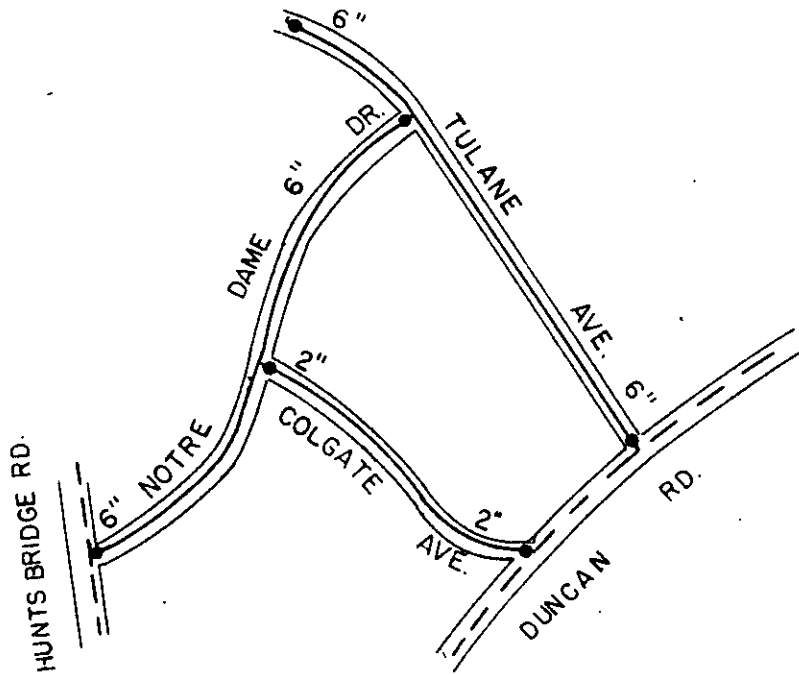

MATERIAL LIST

- 2,800'± - 6" Pipe
- 930'± - 2" Pipe
- 3 - 6" Valves
- 3 - 2" Valves

Recorded May 31, 1968 At 5:04 P.M. # 31101

E. E. Huff, H. Z. Jones &
 J. E. Williams
 TO
 BEREA PUBLIC SERVICE DISTRICT
 4-16