


Recorded May 31, 1968 At 4:54 P.M. # 31142

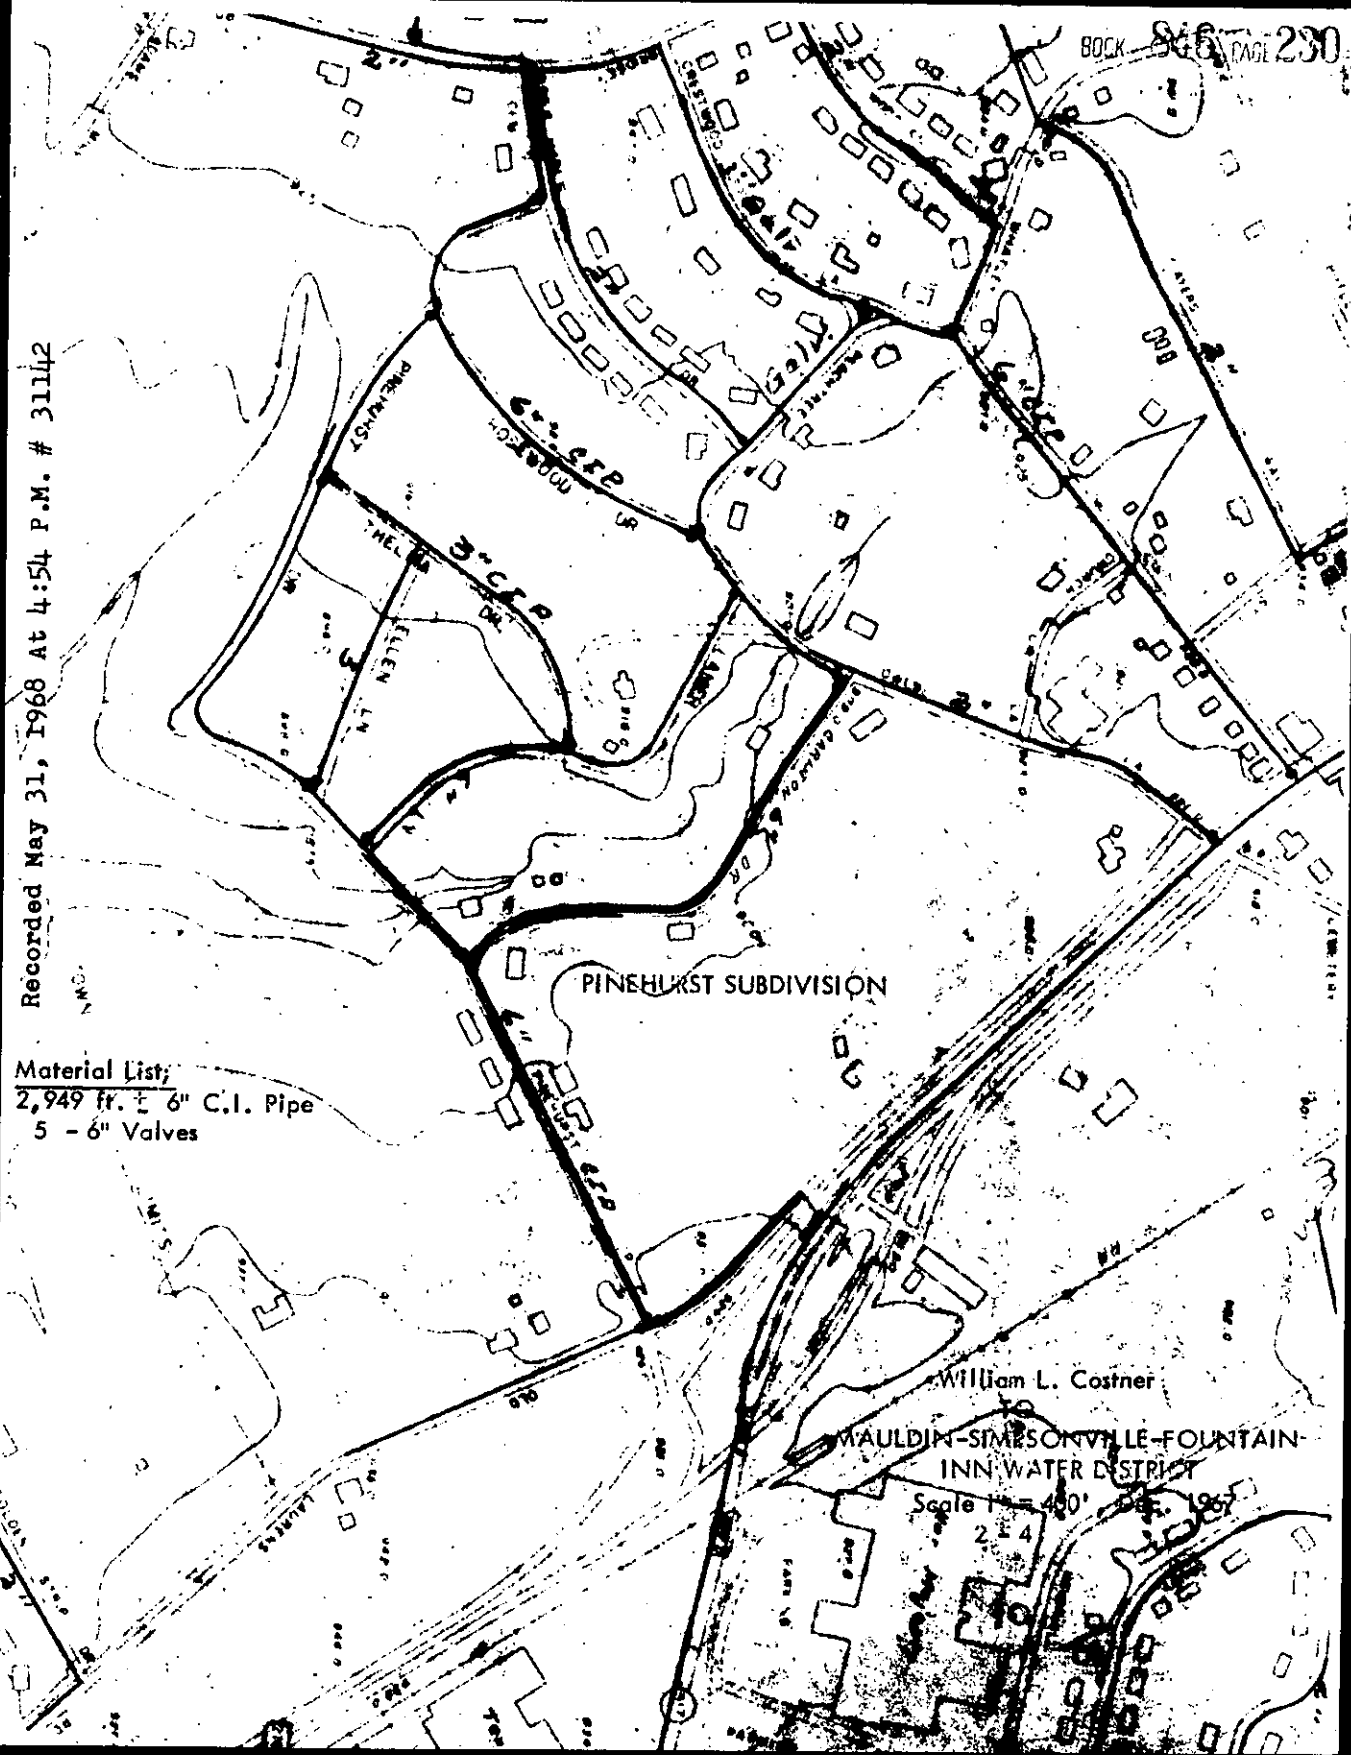

PINEHURST SUBDIVISION

Material List;
 2,949 ft. ± 6" C.I. Pipe
 5 - 6" Valves

William L. Costner
 WAULDIN-SIMPSONVILLE-FOUNTAIN
 INN WATER DISTRICT

 2 1/4
 1967