
State of South Carolina North Carolina

COUNTY OF XXXXXXXXXX MECKLENBURG

PERSONALLY APPEARS before me the undersig	ned deponent, who on oath says that deponent saw the
above named Grantor(s) deliver the within written rig	
CHINE IT. White	, witnessed the execution thereof.
SWORN TO AND SUBSCRIBED before me this	
the day of Street 1965	James R. Muse.
Notary Public for North Caro	Deponent
Notary Public for North Caro	lina
My Commission expires: March ?	1970

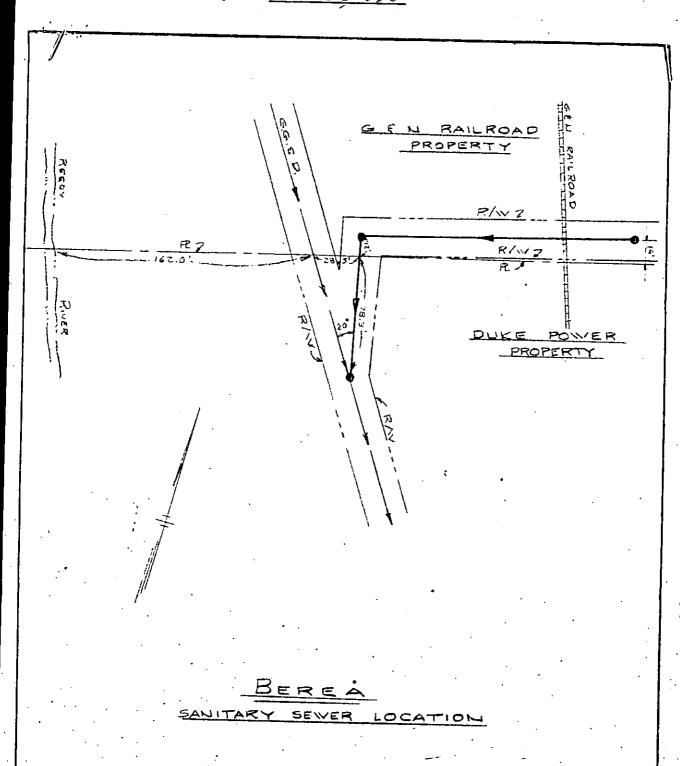

SCALE 1'-50'
PIEDMONT ENGINEERS AND ARCHITECTS

Recorded June 21, 1968 At 10:30 A.M. # 32876.

MAY 1 1965