


E1,618,000

BOOK 848 PAGE 387

E1,620,000

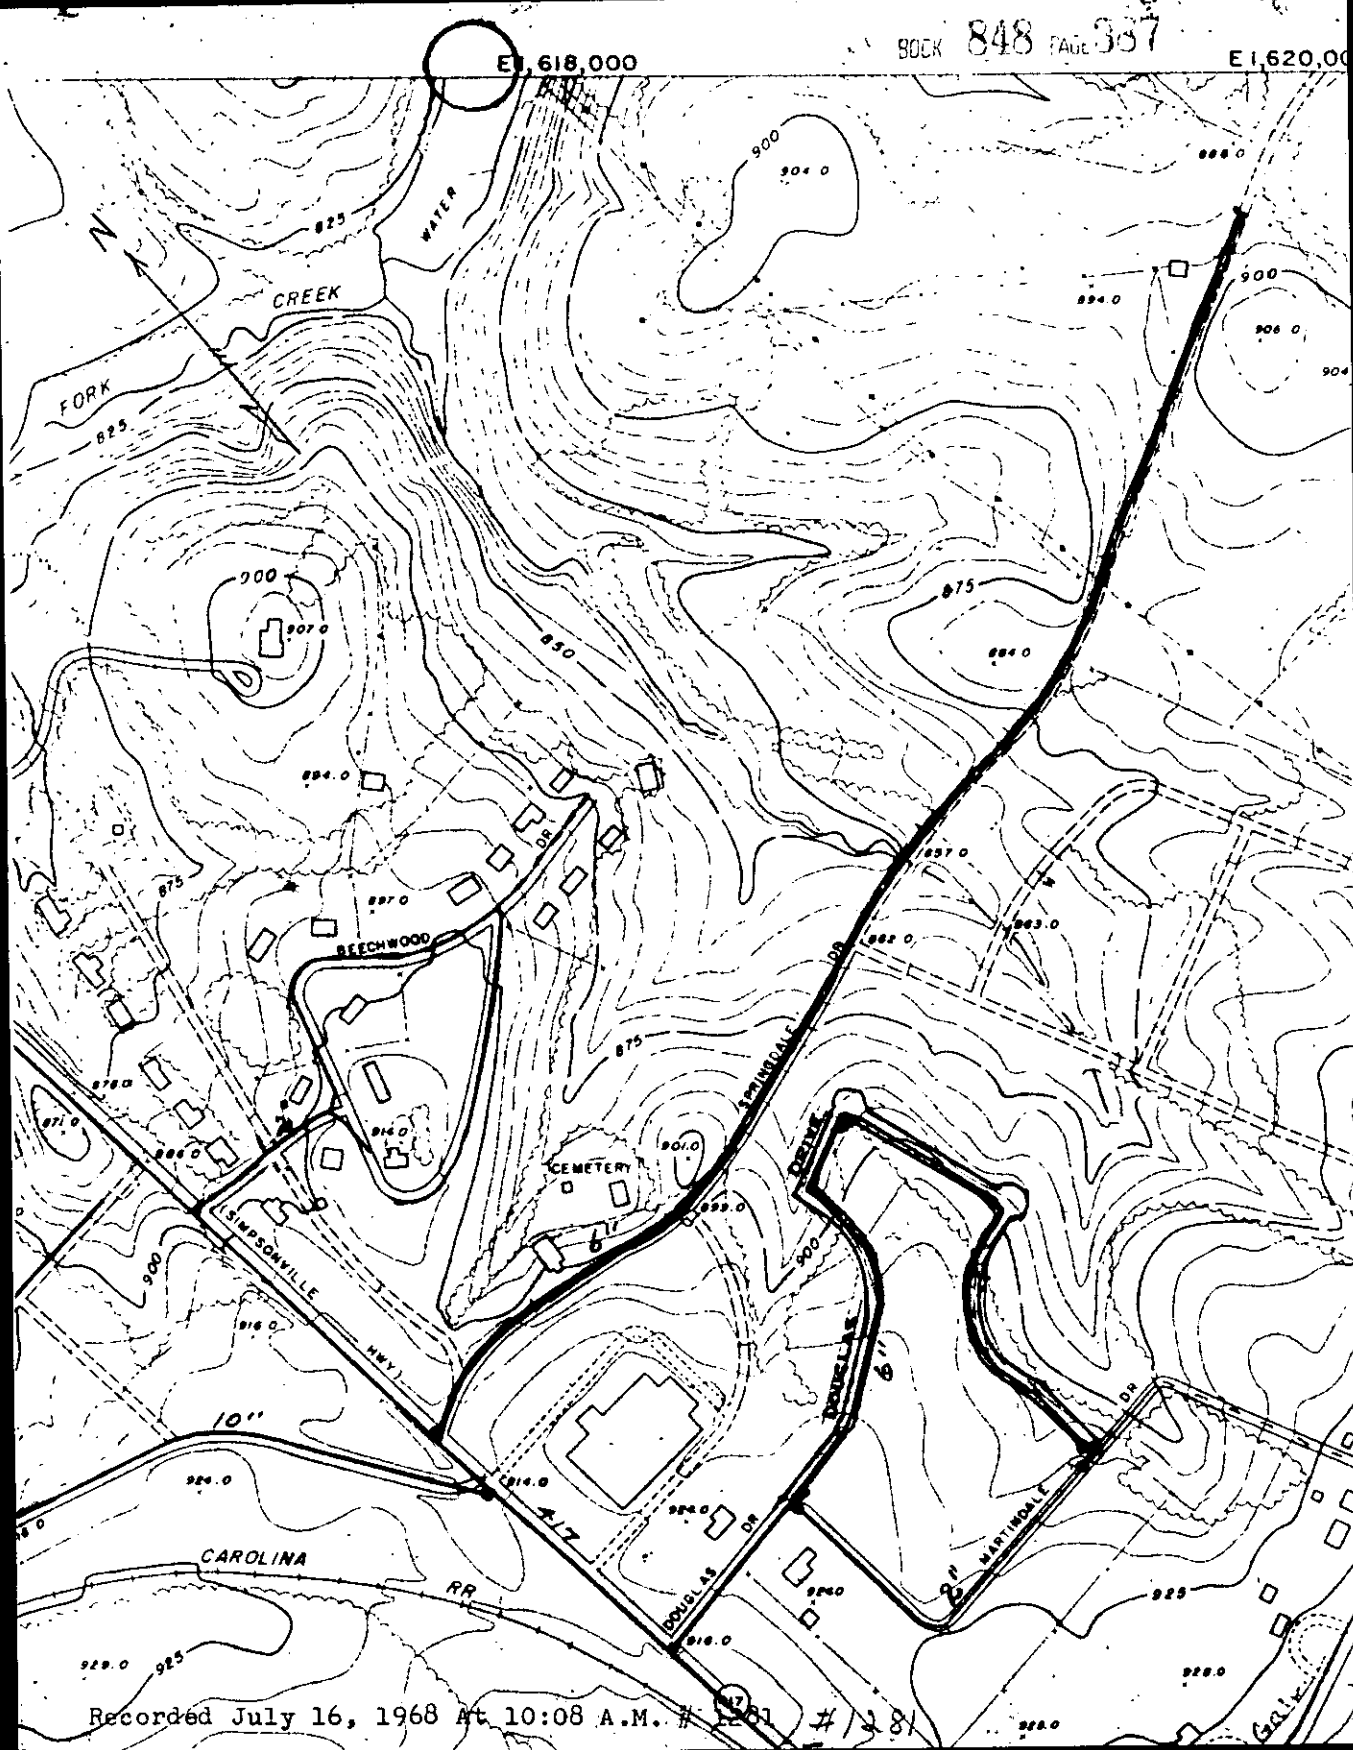

Recorded July 16, 1968 At 10:08 A.M. # 281 # 1281