
HEATHWILDE SUBDIVISION

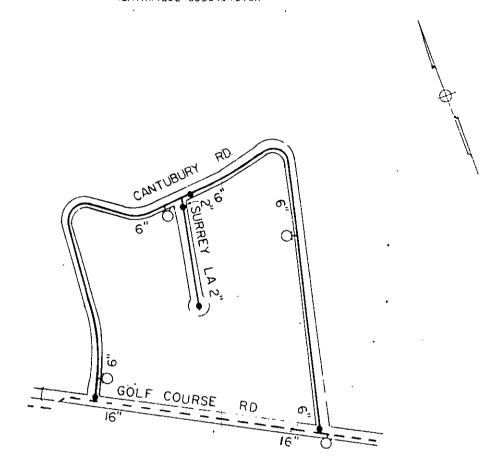

MATERIAL LIST

3,630'± - 6" C.1. Pipe - 2" Galv. Pipe - 6" Valves - 2" Valves - Fire Hydrants 550'±

> William R. Wyatt T0 CITY OF GREENVILLE, S.C.

Scale !" = 400' July 1968

Recorded August 15, 1968 At 5:03 PiM. # 3958