


GREEN BRIAR SUBDIVISION

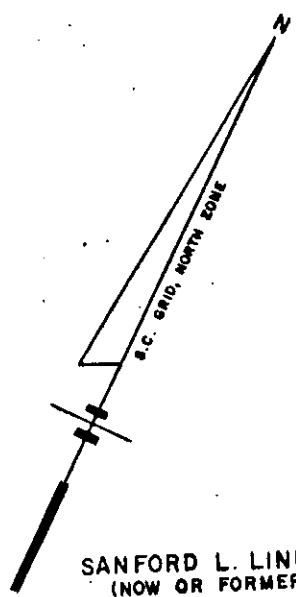


SANFORD L. LINDSEY  
(NOW OR FORMERLY)

P.G. JONES  
REF. DWG. NO. 35-55

AREA = 57.73 ACRES  
 (TOTAL AREA = 57.74 ACRES)  
 - 11.00 SOLD  
 -----  
 46.74

SOLD TO  
 BALLENGER PAVING CO. INC.  
 AREA = 11.0 ACRES

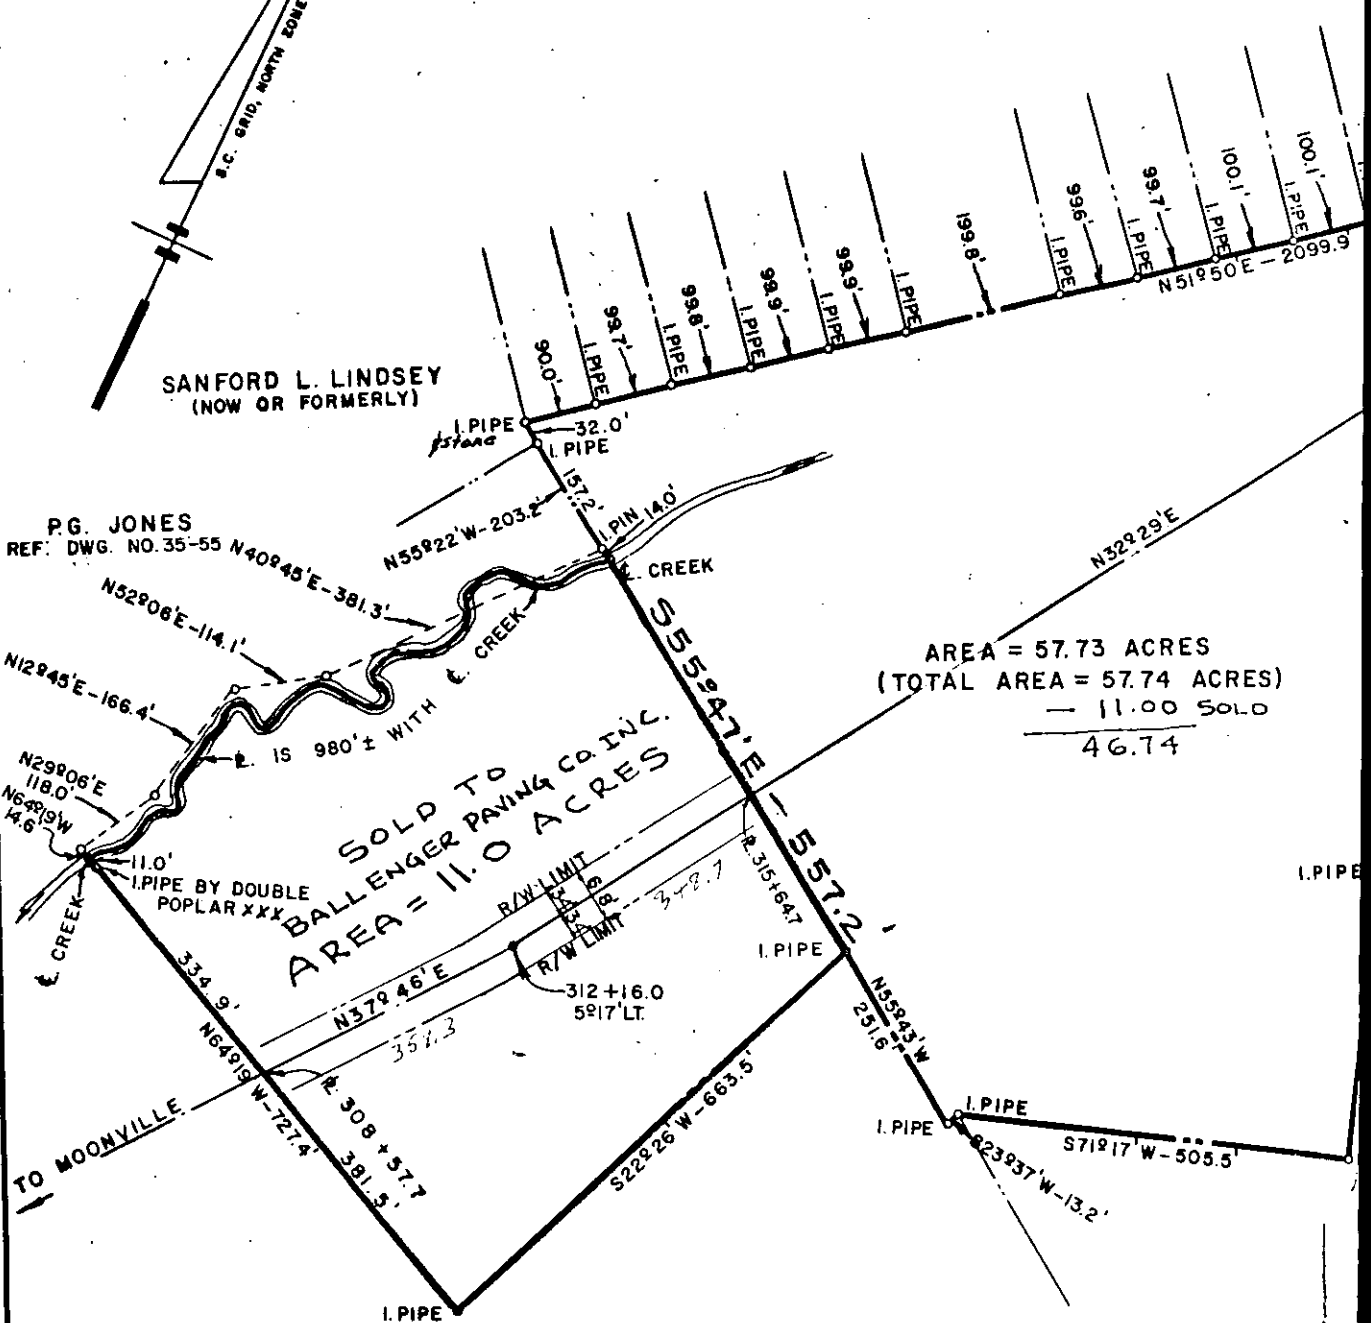

P.G. JONES  
REF. DWG. NO. 35-55