
Defendants

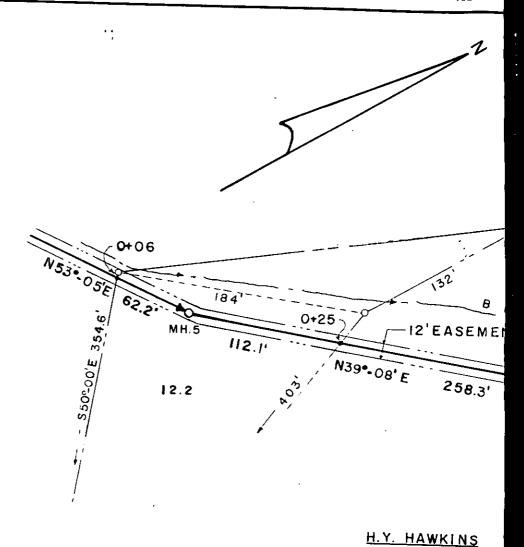

## NOTE:

DISTANCES AND BEARINGS BORDERING J.A. GILBERT WERE OBTAINED FRO DESCRIPTION OF J.A. GILBERT LAND BOUNDARIES RECORDED IN DEED BOO PAGE 418 DISTANCE AND BEARING BORDERING DELMER HAWKINS WERE OBTAINED FROM PLAT OF DELMER HAWKINS PROPERTY RECORDED IN VOLPAGE 71. ALL OTHER BOUNDARIES WERE OBTAINED FROM GREENVILLE MAP NO. 494, SECTION 1., LOTS 12 AND 12.2.

I CERTIFY THE LOCATION OF SEWER LINE ON THE ABOVE PROPERTY TO BE CORRECT TO THE BEST OF MY KNOWLEDGE.

S C. REG. NO. 1574

DAVIS & FLOYD ENGINEERS,
GREENWOOD, S. C.

NO. REVISION CHKD. DATE BY: L M. HALL NO.