


FILED
GREENVILLE CO. S. C.

VOL 888 PAGE 466

APR 24 2 54 PM '70

OLLIE FARNSWORTH
R. H. C.

Mrs. Lilla H. Jones, Owner
to
City of Greenville
March 26, 1970

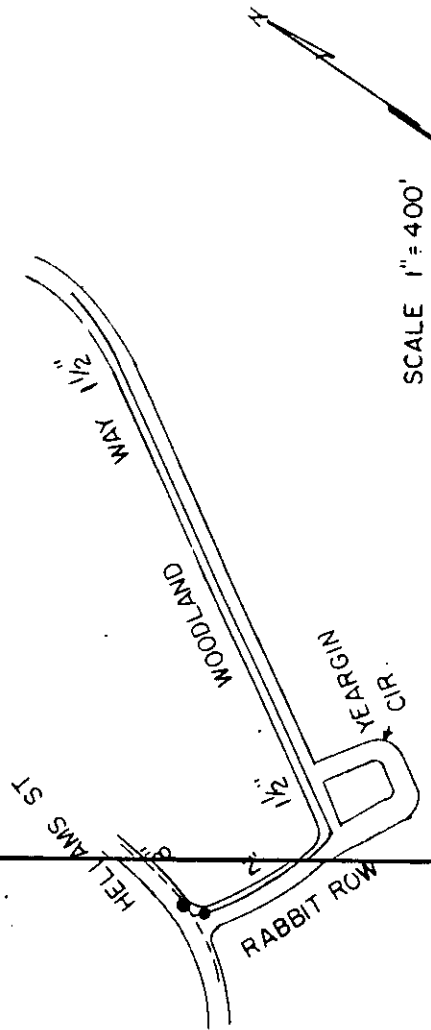

SCALE 1" = 400'

MATERIAL LIST

| | | |
|-------|---|-------------|
| 400' | - | 2' Callv. |
| 1500' | - | 1 1/2" div. |

Recorded April 24th, 1970 at 2:54 P.M. #23297