


South Carolina
 Greenville District
 Pursuant of a reg-
 uest of J. M. G. G.
 Esq. I have
 surveyed part of a
 tract of Land origi-
 nally granted to James
 G. G. situated on both
 sides of ~~White House~~
 White House road near
 Saluda River in

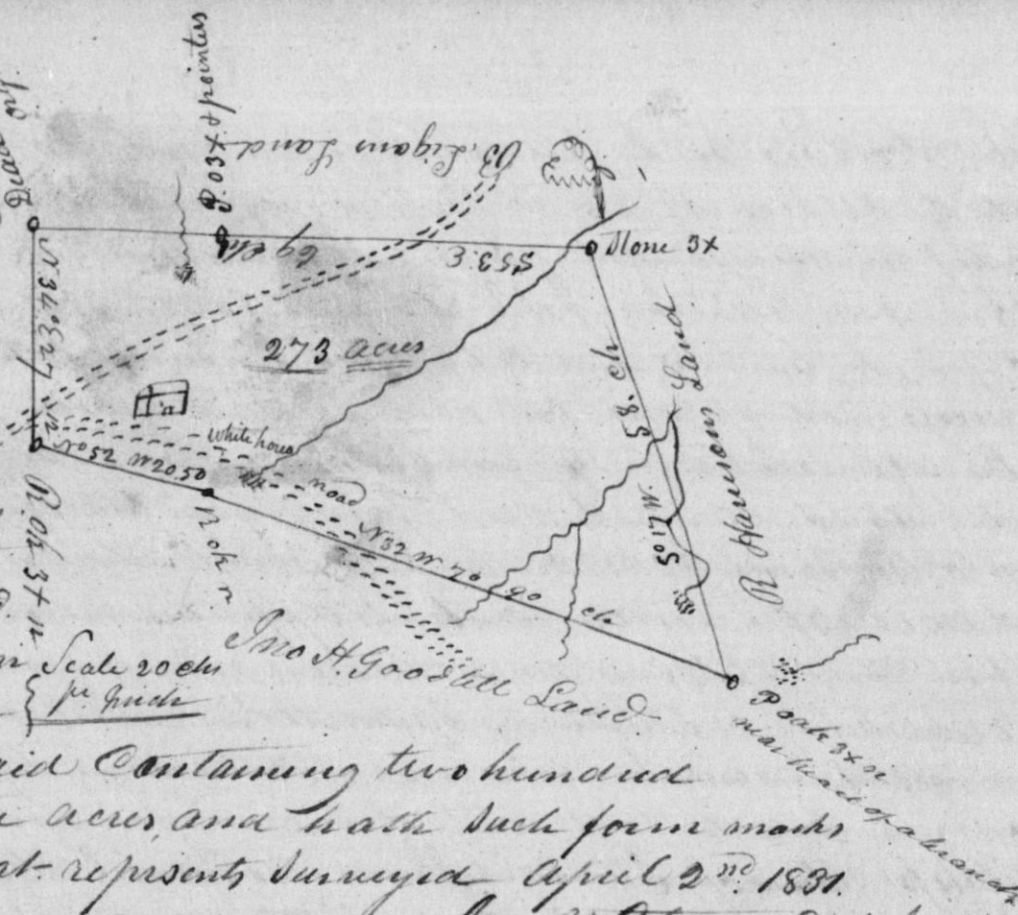

the district aforesaid containing two hundred
 and seventy three acres and hath such form marks
 as the above plat represents surveyed April 2nd 1831.
 J. M. G. G. Dep. Sur.
 Recorded for 6 May 1831

The State of South Carolina, Know all men by these presents
 that I William Hunter of Greenville District and State aforesaid for
 and in consideration of the sum of thirty dollars to me paid by Joshua
 Hawkins of the same place have granted bargained & sold
 and do by these presents grant bargain sell and release unto the said
 Joshua Hawkins a certain piece parcel or tract of land situate
 lying and being in the District and State aforesaid On both sides
 of Mountain Creek Waters of Enoree River bounded by
 William Massens line runs N.E. by James Barnes line N.W. by
 Nathan Bezzy's line S.W. on other sides by vacant Land containing
 One hundred and seventy one acres more or less which Land was ori-
 ginally granted to the said William Hunter by Grant bearing date
 the 6th day of August 1821. As witness to the Original Grant
 will more fully show. And signed by his Excellency John
 Bennett Governor and Commander in Chief in and over
 the State aforesaid Together with all and singular the rights
 membris hereditaments and appurtenances to the said premises
 belonging or in any wise incident or appertaining To Have and
 To Hold all and singular the said premises unto the said Joshua
 Hawkins his heirs and assigns for ever and I do hereby bind
 my self my heirs Executors and administrators to warrant and
 forever defend the said premises unto the said Joshua Hawkins
 his heirs and assigns from me and my heirs and from every
 other person or persons whomsoever lawfully claiming
 or to claim the same or any part thereof In witness