

the said simple of the premises aforesaid
Signed sealed and delivered after the above Intertinction of the words
"and covenant by the said Humphrey Hall in presence of
Lawrence Synhardt"


Jno Watson

Humphrey Hall

South Carolina } John Watson made oath before me the Subscribing
Greenville District } Justice that he saw Humphrey Hall Esq; of the Village
of Henry Hall deceased Sign Seal and deliver the Within deed to the
Honbl Richard Gant for the uses and purposes therein mentioned
and that Lawrence Synhardt was a Subscribing Witness with himself
to the same Sworn to and Subscribed before me this 19th May 1834

Jno Watson
Mc Dayne
C.C.

Jno. Watson

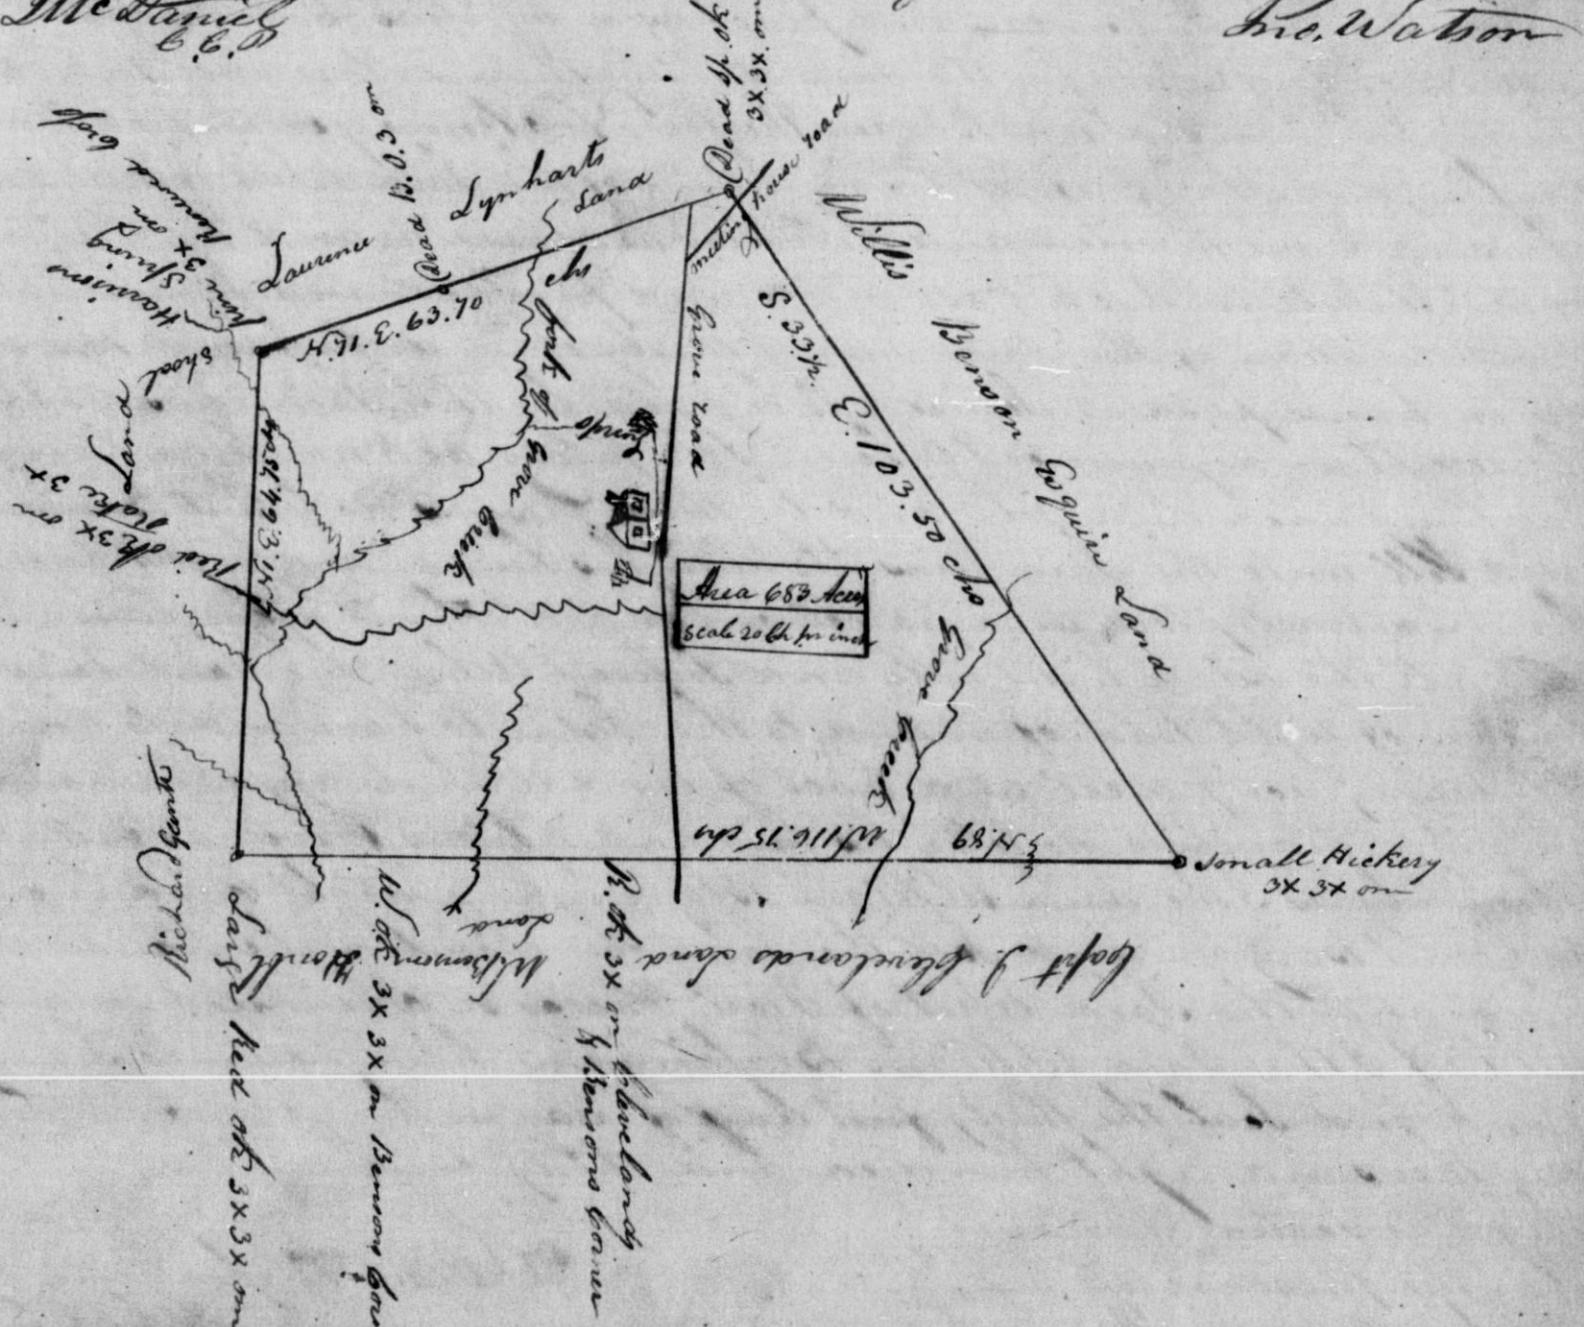

South Carolina } At the Request of the Honbl R Gant I have resurveyed
Greenville District } a tract of land situate in Said district on the head Waters
of Grove Creek originally granted to Capt Henry Hall deceased containing
six hundred and eighty three acres and hath such farm marks bounded &c
as the above plat represents Surveyed April 10th 1834 Jno Watson Q.S.
Recorded for the 19th day of May 1834

South Carolina } To all to whom these presents shall come I William
Greenville District } Blasingame Sheriff of Greenville District and State
aforesaid send greeting Whereas by virtue of a writ of fieri facias issued
out of the Court of Common Pleas held for the district of Spartanburgh
lasted the tenth day of October in the year of our Lord one thousand
Eight hundred and thirty at the suit of Thomas Campbell to me